
FORM 51 5M 4-41 PETROL

Greenwood KANSAS

Section 25 Township 27 Range 8E

Well No. 9 Lewis "A"

Company K. T. Weidman et al

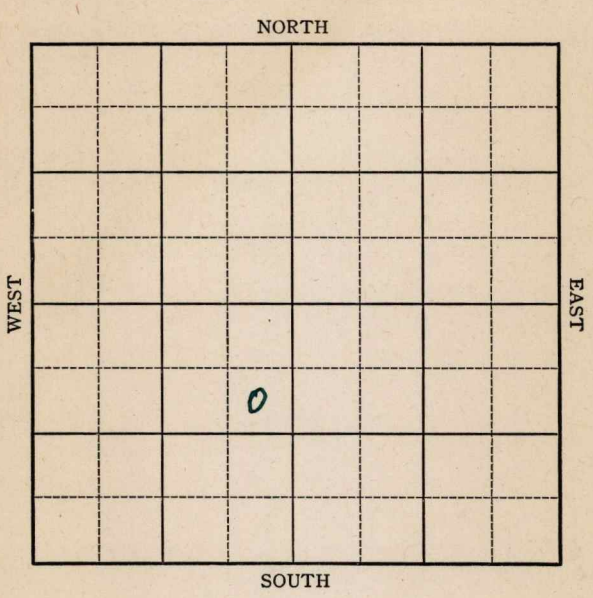

FORM 252-A 5M 1-41 PETROL KANSAS Greenwood

Sec. 25 Twp. 27 R. 8-E

Well No. #9 Lewis "A" Farm

K. T. Weidman et al Company


(Beaumont)

990 Ft. from N. Line

Ft. from S. Line

330 Ft. from E. Line

Ft. from W. Line

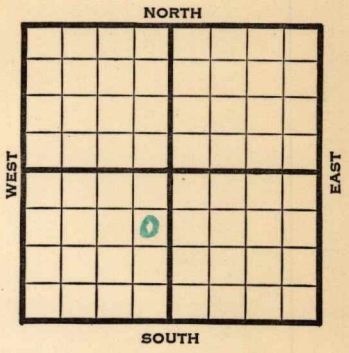

1941	REPORT
6/18	Spud.
6/26	15" - 9' Drlg. 675'
7/3	" " "
7/10	12" - 780' 10" - 1195'
	Drlg. 1540'
7/17	1790' U.R. 8".
7/24	8" @ 1724' Peru 1831' Drlg. 2170'
7/31	6" @ 2413' WOC
8/7	Miss 2449' TD 2426' 1000 acid.
8/13	Miss. 2419'
	6" - 2413'
	2000 acid
	Pot. 25 bbls oil
	Grav. 36.4
	COMPLETED

Form 26 200 Bks. 5-41 McW. Greenwood KANSAS

Map No. 10 Sec. 25 Twp. 27 R. 8E

Well No. 9 Lewis "A"

K. T. Weidman etal Company

FIRST REPORT Contractor

SE NE SW

990 Ft. from N. Line


Ft. from S. Line

330 Ft. from E. Line

Ft. from W. Line

BEAUMONT POOL

SECTION PLAT

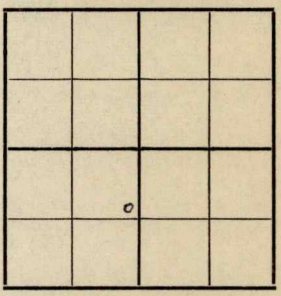

Location

Rig up

Drilling and Remarks:
Spud

RECORD

Cased in., ft.

Sand

Gas

Oil

Total Depth

PRODUCTION

1st 24 hrs. Nat.

1st 24 hrs. after shot

Gas Cu. Ft.

Dry Hole

Abandoned

Date

JUN 18 1941 19

S. J. LEWIS Scout

Form 26 1200 Bks. 7-41 McW. Greenwood

KANSAS

Map No. 10 Sec. 25 Twp. 27 R. 8E

Well No. 9 Lewis "A"

K. T. Weidman etal Company

Contractor

COMPLETED

SE NE SW

990 Ft. from N. Line


Ft. from S. Line

330 Ft. from E. Line

Ft. from W. Line

BEAUMONT POOL

SECTION PLAT

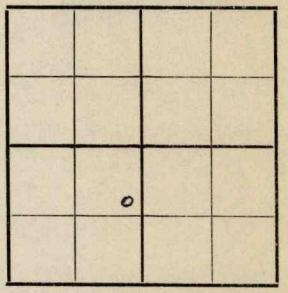

Location

Rig up

Drilling and Remarks:

Miss ~~2449~~ 2419

6" 2413

2000 acid

Pot 25 bbl oil

RECORD

Cased in., ft.

Sand

Gas

Oil

Total Depth

PRODUCTION

1st 24 hrs. Nat.

1st 24 hrs. after shot

Gas Cu. Ft.

Dry Hole

Abandoned

36 grav

Date

8/13/41 19 S. J. LEWIS Scout