

KANSAS

FORM 51 5M 1-42 PETROL

Greenwood

Section 25 Township 27 Range 8-E

Well No. #10 Lewis "A"

Company K. T. Wiedemann

NORTH

0							

SOUTH

WEST

EAST

KANSAS

Greenwood

Sec. 25 Twp. 27 R. 8-E

Well No. #10 Lewis "A" Farm


K. T. Wiedemann Company

 Ft. from N. Line

330 Ft. from S. Line

 Ft. from E. Line

330 Ft. from W. Line

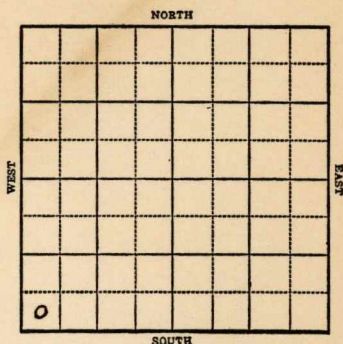

1943

R E P O R T

8/11

12" @ 903'
10" @ 1128'
K.C. 1672'
1775' - 1/3 M. Gas
8" @ 1777'
Pern. 1800'
Drlg. 2065'

8/18

" "

8/25

Miss 2429
T.D. 2447
7" @ 2430
200' oil 12 hrs.

9/1

Miss 2429
7" @ 2430
1000 acid
Pump 15 Pot.
T.D. 2447
Grav. 36

COMPLETED

KANSAS
 Map No. 70 Sec. 25 Twp. 27 R. 8E

Well No. 10 Lewis "A"

K. T. Wiedemann Company

FIRST REPORT Contractor

SW/C


SECTION PLAT

 Ft. from N. Line

330 Ft. from S. Line

 Ft. from E. Line

330 Ft. from W. Line

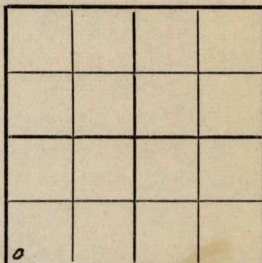

MISCELLANEOUS

Location

Rig up

Drilling and Remarks:

12"-903'

10"-1128'

K.C. 1672'

1775'-1/3 M. Gas

8"-1777'

Pern. 1800'

Drlg. 2065'

RECORD

Cased in., ft.

Sand

Gas

Oil

Total Depth

PRODUCTION

1st 24 hrs. Nat.

1st 24 hrs. after shot

Gas Cu. Ft.

Dry Hole

Abandoned

Date

AUG 11 1943 19

S. J. LEWIS

Scout

KANSASMap No. 10 Sec. 25 Twp. 27 R. 8EWell No. 10 Lewis "A"K. T. Wiedemann CompanyCOMPLETED Contractor

SW/C

SECTION PLAT

 Ft. from N. Line330 Ft. from S. Line Ft. from E. Line330 Ft. from W. Line

Miscellaneous

Location Rig up

Drilling and Remarks:

*Miss 2429**7" C 2430**1000 acid**Pump 15 P & X**86 1/2 ft*

RECORD

Cased in., ft.Sand Gas Oil Total Depth 2447

PRODUCTION

1st 24 hrs. Nat. 1st 24 hrs. after shot Gas Cu. Ft.Dry Hole Abandoned

Date

SEP 1 1943

19

S. J. LEWIS

Scout