


Map No. Kans Sec. 19 Twp. 32 R. 3

Well No. 3 White Farm \_\_\_\_\_  
Carter oil Company \_\_\_\_\_

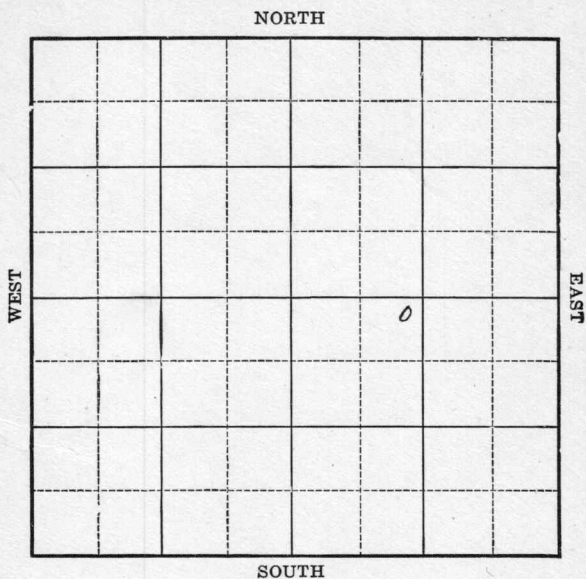

Location \_\_\_\_\_

Drilling Remarks

\_\_\_\_\_

\_\_\_\_\_

Rig Up \_\_\_\_\_

Drilling Remarks

\_\_\_\_\_

\_\_\_\_\_

**RECORD**

Cased \_\_\_\_\_ in. \_\_\_\_\_ ft.

Sand \_\_\_\_\_

Gas \_\_\_\_\_

Oil \_\_\_\_\_

Total Depth \_\_\_\_\_

**PRODUCTION**

1st 24 hrs. Nat. \_\_\_\_\_

1st. 24 hrs. after shot \_\_\_\_\_

Gas \_\_\_\_\_ cu. ft.

Dry Hole \_\_\_\_\_

Abandoned \_\_\_\_\_

Map No. *Kansas* Sec. *19* Twp *32* R *3*


Well No. *3 Warts* Farm  
*Carter Oil* Company

*330* Ft. from N. Line

..... Ft. from S. Line

..... Ft. from E. Line

*990* Ft. from W. Line

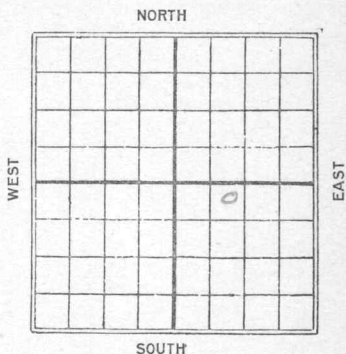

*Beneas*

Date *1925* REPORT

*3/24 Spud*  
*5/20 water*  
 52690-2200 Plug to 2640 oval. 250 oil  
 15 bbl. water

Map No. **KANSAS** Sec. **19** Twp. **32** R. **3**

Well No. **3** *Waite*

*Carter Oil* Company

Contractor

**FIRST REPORT**

**SECTION PLAT**

**330** Ft. from N. Line

----- Ft. from S. Line

----- Ft. from E. Line

**990** Ft. from W. Line

		○	

Location -----

Rig up -----

Drilling and Remarks:

*Specs*

**RECORD**

Cased ----- in., ----- ft.

Sand -----

Gas -----

Oil -----

Total Depth -----

**PRODUCTION**

1st 24 hrs. Nat. -----

1st 24 hrs. after shot -----

Gas ----- Cu. Ft.

Dry Hole -----

Abandoned -----

Date

**3/24** 192**5**

**M. A. BENEAR**

Scout

*Cawley Co.*

**KANSAS**

Map No. \_\_\_\_\_ Sec. *19* Twp. *32* R. *3E*

Well No. *3 Waitt*

*Carter Oil*

Company

Contractor

# COMPLETED SECTION PLAT

*330'* Ft. from N. Line

\_\_\_\_\_ Ft. from S. Line

\_\_\_\_\_ Ft. from E. Line

*990'* Ft. from W. Line

		○	

Location \_\_\_\_\_

Rig up \_\_\_\_\_

Drilling and Remarks:

*water s. 2690-2700*  
*Plug. back 2640*  
*swabbing 250 lbs air*  
*15 lbs water*

## RECORD

Cased \_\_\_\_\_ in., \_\_\_\_\_ ft.

Sand *oil 2595-2625*

Gas \_\_\_\_\_

Oil \_\_\_\_\_

Total Depth \_\_\_\_\_

## PRODUCTION

1st 24 hrs. Nat. \_\_\_\_\_

1st 24 hrs. after shot \_\_\_\_\_

Gas \_\_\_\_\_ Cu. Ft.

Dry Hole \_\_\_\_\_

Abandoned \_\_\_\_\_

Date

MAY 20 1925

**M. A. BENEAR**

192

Scout