


Russell

DX 78-1

KANSAS

Section 25 Township 13 Range 15W
Well No. #1 Strecker
Company E.F. Wakefield

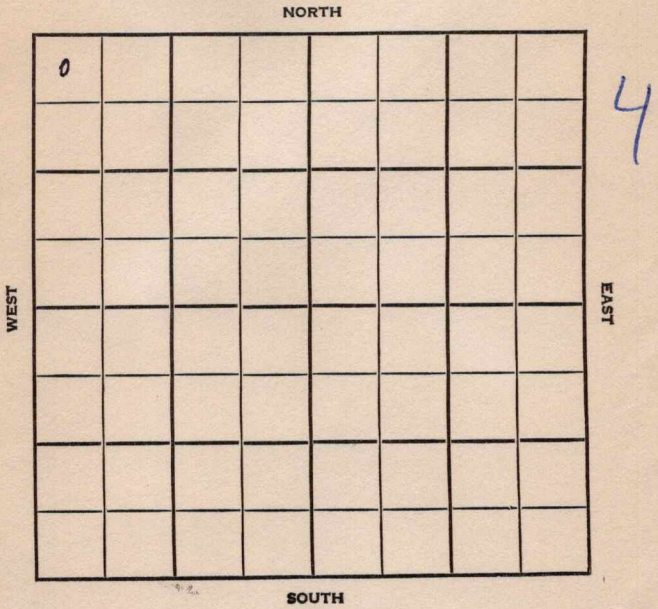

Russell

KANSAS

SEC.	TWP.	R.
25	13	15W

WELL NO.

#1 Strecker

FARM

COMPANY

E.F. Wakefield.

CONTRACTOR

Co. Tools.

330

Ft. from N. Line


Ft. from S. Line

Ft. from E. Line

330

Ft. from W. Line

NW NW NW

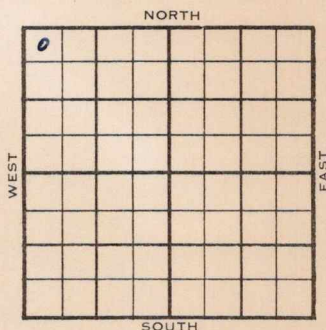

1954

ELEVATION

1892'

REPORT

12/15

Spud 12-12-54
Drlg. 150'1955
2/9

Spud 12-12-54

Oil Well

TD 3333'

13" @ 630'

Anhy 945'

10" @ 945'

Tarkio 2467'

8" @ 2535'

Top 2780'

TD 3333'

5" @ 3329'

Lans 3050' Arb. 3329'

CO to 3333

B/ 10 goph 500 A S/ 100 bo 12 hr.

Comp 60 bopd.

COMPLETED

County **Russell** State **Kansas**
 Sec. **25** (Blk. Twp.) **13** (Sur. Rge.) **15W** Map No.
 Operator **E. F. Wakefield**
 Well No. **1** Farm **Strecker**
 Elev. Location **NW NW NW**

0							

FIRST REPORT

330 Ft. From **N** Line **NW**
330 Ft. From **W** Line Quarter

1st. Report **DEC 15 1954**

Completion

Remarks

Co. tools

Spudding Date **12-12-54**

Drlg. Data

drlg. 150

FABEN GILSTRAP

County Russell State Kansas
 Sec. 25 (Blk. 13) (Sur. 15W) Map No. 13
 Operator E. F. Wakefield
 Well No. 1 Farm Strecker
 Elev. 1892 Location NW NW NW

0					

330 Ft. From N Line NW330 Ft. From W Line Quarter

1st. Report

Completion FEB 9 1955

Remarks

Co. toolsSpudding Date 12-12-54Drlg. Data Oil well TD 333313" @ 630 Anhy 945 10" @ 945Tarkio 2467 8" @ 2535 Top. 2780TD 3333 5" @ 3329 Lans. 3050Arb. 3329 CO to 3333 B/ 10 goph500 A S/ 100 bo 12 hr. Comp. 60 bopd

FABEN GILSTRAP