

KANSAS


Russell

FORM 51 5M PETROL

Section 25 Township 13 Range 15W

Well No. 1 Strecker

Company John Lindas

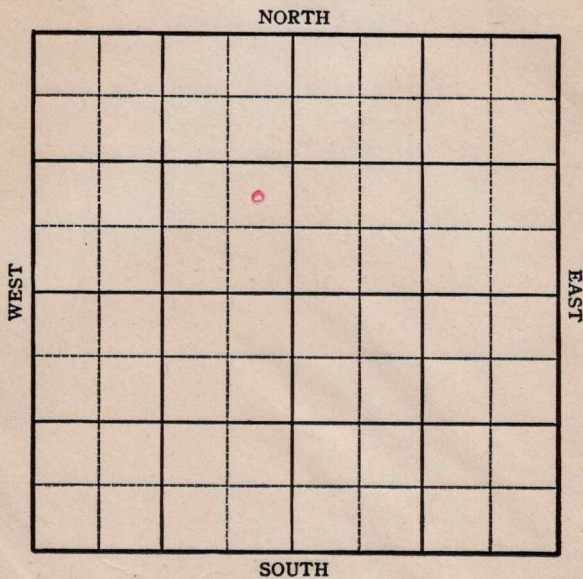

KANSAS

Russell County

Sec. 25 Twp. 13 R. 15W

Well No. #1 Strecker Farm

John Lindas

Company


Atherton

Ft. from N. Line

990 Ft. from S. Line

330 Ft. from E. Line

Ft. from W. Line

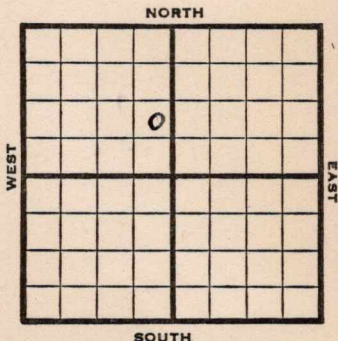

NE SE NW

Elev. 1891

REPORT

1945

10/31 8" @ 233
Drlg. 1980'

11/7 **Anhy. 940**
Fishing 2385

11/14 TD 2385'
Skid rig. 16' south
8" @ 245
Drlg. 1730'

11/21 Drlg. 2963'

11/28 **Topeka 2744**
Lans 3057-3107
TD 3107
5" @ 3087 RUST

12/5 Bailing mud

12/12 **Lans 3057**
5" @ 3087
TD 3107'

ABANDONED

KANSASKansas Pool Name AthertonMap No. 72 Sec. 25 Twp. 13 R. 15WWell No. 1 Strecker


John Lindas

Company

FIRST REPORT

Contractor

NE SE NW

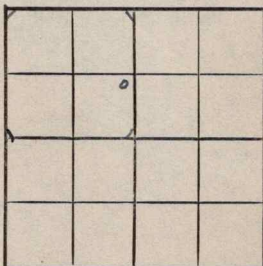SECTION PLAT Ft. from N. Line990 Ft. from S. Line330 Ft. from E. Line Ft. from W. LineRussell CountyLocation Rig up

Drilling and Remarks:

8"-2331980**RECORD**Cased in., ft.Sand Gas Oil Total Depth **PRODUCTION**1st 24 hrs. Nat. 1st 24 hrs. after shot Gas Cu. Ft.Dry Hole Abandoned

Date

OCT 31 194519S. J. LEWIS

Scout

KANSASKansas Pool Name AthertonMap No. K-72 Sec. 25 Twp. 13 R. 15WWell No. 1 StreckerJohn Lindas

Company

ABANDONED

Contractor

E. 11891

NE SE NW

SECTION PLAT

	0		

 Ft. from N. Line990 Ft. from S. Line330 Ft. from E. Line Ft. from W. LineRussell County**Location****Rig up****Drilling and Remarks:***Lans 3057**S-C 3087***RECORD**Cased in., ft.Sand Gas Oil Total Depth 2157**PRODUCTION**1st 24 hrs. Nat. 1st 24 hrs. after shot Gas Cu. Ft.Dry Hole Abandoned

Date

DEC 12 1945 19S. J. LEWIS

Scout