
Form 51—5M—11-38—Palace

Greenwood KANSAS

Section 25 Township 27 Range 8-E

Well No. #1 Temple

Company K. T. Wieeman

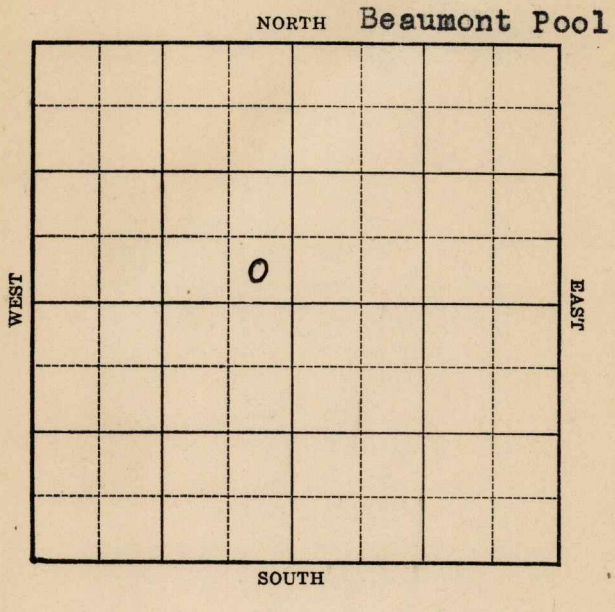

FORM 252-A 5M 4-39 KANSAS Greenwood

Sec. 25 Twp. 27 R. 8E

Well No. #1 Temple Farm

K. T. Wiceman Company


(Beaumont Pool)

____ Ft. from N. Line

330 Ft. from S. Line

330 Ft. from E. Line

____ Ft. from W. Line

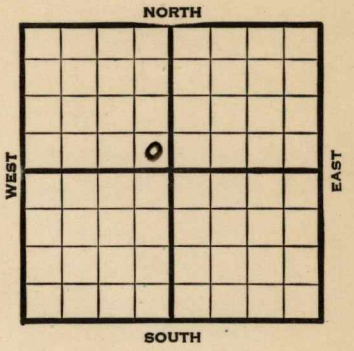

1939	REPORT
6/7	Spud
6/16	Spud & SD.
6/23	10" - 420' Drlg. 735'
6/29	50,000 gas at 930' Drlg.
7/6	Shut down.
7/13	Fsg. 1150'
7/20	8" - 1170' Drlg. 1350'
7/27	Drlg. 1465'
8/3	K. C. 1686' Drlg. 1785'
8/10	Peru Sand 1816-35' No shows.
	Drlg. 1985'
8/17	6" - 2020' Drlg. 2240'
8/24	Chat. 2416' TD 2450' S.O.
	Shut down.
8/31	" "
9/7	T.D. 2515' 1½ bbls. oil a day.
	Plug back.
9/14	P. B. 2460' 100 acid.
9/21	5" - 2404' WOC.
9/28	" " "
10/5	" " "
	OVER

1939

10/12 T.D. 2515'
P.B. 2460'
5" - 2404'
WOC.

10/18 Chat. 2416'
5" - 2404'
T.D. 2515'
P. B. to 2426'
2500 acid.
5 bbls. oil.

COMPLETED

Form 26—1M Bks.—2-29 Greenwood KANSAS

Map No. 10 Sec. 25 Twp. 27 R. 8E

Well No. 1 Temple

K. T. Wieeman Company

Contractor

COMPLETED

SE NW

Ft. from N. Line


330 Ft. from S. Line

330 Ft. from E. Line

Ft. from W. Line

BEAUMONT POOL

SECTION PLAT

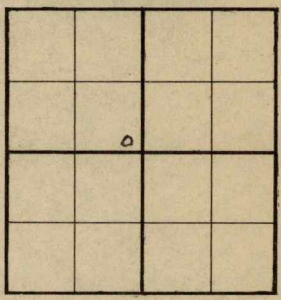

Location

Rig up

Drilling and Remarks:

Chat 2416
5" @ 2404
P.B. 2426
2500 acid
SWK

RECORD

Cased in., ft.

Sand

Gas

Oil

Total Depth 2515

PRODUCTION

1st 24 hrs. Nat.

1st 24 hrs. after shot

Gas Cu. Ft.

Dry Hole

Abandoned

Date

OCT 18 1939 19 S. J. LEWIS Scout

Form 26—1M Bks.—2-29

KANSAS

Greenwood

Map No. 10 Sec. 25 Twp. 27 R. 8E

Well No. 1 Temple

K. T. Wieeman Company

Contractor

FIRST REPORT

SE NW

_____ Ft. from N. Line


330 Ft. from S. Line

330 Ft. from E. Line

_____ Ft. from W. Line

BEAUMONT POOL

SECTION PLAT

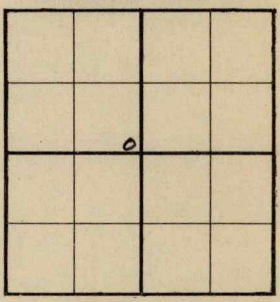

Location _____

Rig up _____

Drilling and Remarks:

Spud.

RECORD

Cased _____ in., _____ ft.

Sand _____

Gas _____

Oil _____

Total Depth _____

PRODUCTION

1st 24 hrs. Nat. _____

1st 24 hrs. after shot _____

Gas _____ Cu. Ft.

Dry Hole _____

Abandoned _____

Date

JUN 7 1939 19____

S. J. LEWIS Scout