


Map No. _____ Sec. 25 Twp. 32 R. 3

Well No. 1 Shelton Farm _____
Tom Johnson Company _____

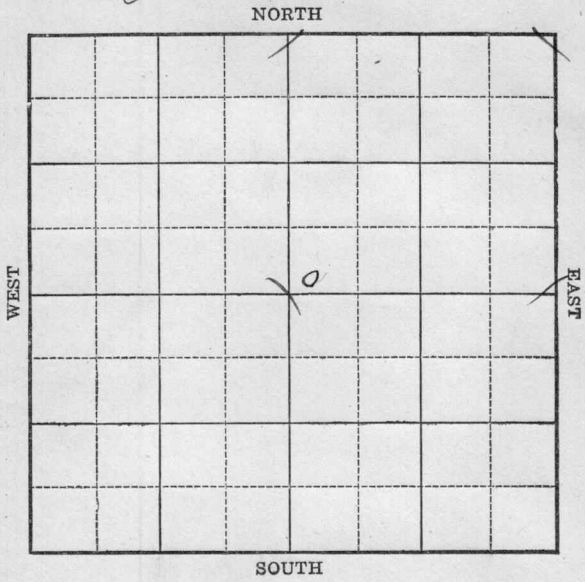

Location _____

Drilling Remarks:

Rig up _____

Drilling Remarks:

RECORD

Cased _____ in. _____ ft.

Sand _____

Gas _____

Oil _____

Total Depth _____

PRODUCTION

1st 24 hrs Nat. _____

1st 24 hrs. after shot _____

Gas _____ cu. ft.

Dry Hole _____

Abandoned _____

Map No. _____ Sec. 25 Twp. 32 R. 3


Well No. 1 Shelton Farm
Tom Johnson Company

_____ Ft. from N. Line

200 Ft. from S. Line

_____ Ft. from E. Line

200 Ft. from W. Line

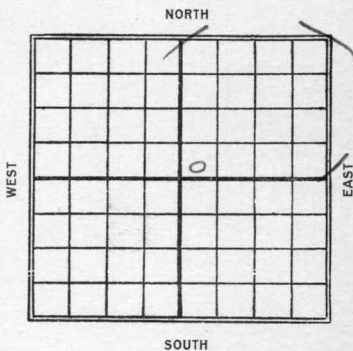

Date
1923

REPORT

8/8 Dlg 2300'

7/16 R + A. @ 3265'

Cowley Co

Map No. *1 Kane* Sec. *25* Twp. *52* R. *3*

Well No. *1 Shelton*

Tom Johnson Company

Contractor

First Report

SECTION PLAT

----- Ft. from N. Line

200 Ft. from S. Line

----- Ft. from E. Line

200 Ft. from W. Line

| | | | |
|--|--|---|---|
| | | | |
| | | 0 | 1 |
| | | | |
| | | | |

Location -----

Rig up -----

Drilling and Remarks:

8/10/43 2300'

RECORD

Cased ----- in., ----- ft.

Sand -----

Gas -----

Oil -----

Total Depth -----

PRODUCTION

1st 24 hrs. Nat. -----

1st 24 hrs. after shot -----

Gas ----- Cu. Ft.

Dry Hole -----

Abandoned -----

Date

8/4 3

192

MPD

Scout

Map No. 1 Kans 25 Sec. 25 Twp. 32 R. 3

Well No. 1 shelton

Tow Johnson Company

Contractor

ABANDONED

SECTION PLAT

----- Ft. from N. Line

200' Ft. from S. Line

----- Ft. from E. Line

200' Ft. from W. Line

| | | | |
|--|--|---|--|
| | | | |
| | | 0 | |
| | | | |
| | | | |

Location -----

Rig up -----

Drilling and Remarks:

449
3265'

RECORD

Cased ----- in., ----- ft.

Sand -----

Gas -----

Oil -----

Total Depth -----

PRODUCTION

1st 24 hrs. Nat. -----

1st 24 hrs. after shot -----

Gas ----- Cu. Ft.

Dry Hole -----

Abandoned -----

Date

M.A.B. 7/23/24

MAP NO. _____ SEC. 75 TWP. 37S R. 3E

WELL NO. 1 Well

J. Johnson et al COMPANY

CONTRACTOR _____

SECTION PLAT

| | | | |
|--|--|---|--|
| | | | |
| | | 0 | |
| | | | |
| | | | |

_____ FT. FROM N. LINE

_____ FT. FROM S. LINE

_____ FT. FROM E. LINE

_____ FT. FROM W. LINE

LOCATION _____

RIG UP _____

DRILLING AND REMARKS:

OK

RECORD

CASED _____ IN. _____ FT.

SAND _____

GAS _____

OIL _____

TOTAL DEPTH 3765

PRODUCTION

1ST 24 HRS. NAT. _____

1ST 24 HRS. AFTER SHOT _____

GAS _____ CU. FT.

DRY HOLE ✓

ABANDONED ✓

DATE 8/28 1923

SCOUT