

Cowley

Map No. *Kansas* Sec. *19* Twp. *32* R *2*

Well No. *8* *Waite* Farm


Carte Oil Company

1070 Ft. from N. Line

Ft. from S. Line

Ft. from E. Line

1070 Ft. from W. Line

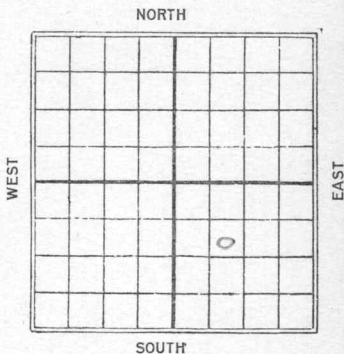

Beneas

Date REPORT

1925

5/18 Location

6/5 _____

7/5 _____

7/22 _____

7/29 _____

8/7 _____

8/14 _____

8/19 _____

8/27 _____

9/2 _____

9/9 _____

9/16 _____

9/24 _____

9/30 _____

10/6 _____

12/22 Top sand 2605 T.D. 2621

135 Bbls 24 hours

38 Gravity

Cawley

KANSAS

Map No. _____ Sec. *19* Twp. *32* R. *3*

Well No. *7 Waitt*

Carter

Company

Contractor

FIRST REPORT

SECTION PLAT

1670 Ft. from N. Line

_____ Ft. from S. Line

_____ Ft. from E. Line

1070 Ft. from W. Line

Location *✓✓*

Rig up _____

Drilling and Remarks:

RECORD

Cased _____ in., _____ ft.

Sand _____

Gas _____

Oil _____

Total Depth _____

PRODUCTION

1st 24 hrs. Nat. _____

1st 24 hrs. after shot _____

Gas _____ Cu. Ft.

Dry Hole _____

Abandoned _____

Date **MAY 18 1925**

M. A. BENEAR

192

Scout

Map No. **KANSAS** Sec. 19 Twp. 32 R. 2

Well No. 7 Wait

Carter

Company

Contractor

SECTION PLAT

1070 Ft. from N. Line

_____ Ft. from S. Line

_____ Ft. from E. Line

1070 Ft. from W. Line

		0	

Location _____

Rig up _____

Drilling and Remarks:

No Changed to # 8

Change from #7 to 8

RECORD

Cased _____ in., _____ ft.

Sand _____

Gas _____

Oil _____

Total Depth _____

PRODUCTION

1st 24 hrs. Nat. _____

1st 24 hrs. after shot _____

Gas _____ Cu. Ft.

Dry Hole _____

Abandoned _____

Date

JUN 5 1925

192_____

M. A. BENEAR

Scout

KI Country
Map No. **KANSAS** Sec. 19 Twp. 32 R. 3E

Well No. 8 Wait.

Carted Oil Company

Contractor

SECTION PLAT

990 Ft. from N. Line

_____ Ft. from S. Line

_____ Ft. from E. Line

990 Ft. from W. Line

Changed Location

Location _____

Rig up _____

Drilling and Remarks:

Cellar

RECORD

Cased _____ in., _____ ft.

Sand _____

Gas _____

Oil _____

Total Depth _____

PRODUCTION

1st 24 hrs. Nat. _____

1st 24 hrs. after shot _____

Gas _____ Cu. Ft.

Dry Hole _____

Abandoned _____

Date

OCT 28 1905

S. J. LEWIS

Scout

Map No. **KANSAS** / Sec. 19 Twp. 22 R. 3E

Well No. S. Haute

Carter Oil Company

Contractor

SECTION PLAT

		0	

990 Ft. from N. Line

_____ Ft. from S. Line

_____ Ft. from E. Line

990 Ft. from W. Line

COMPLETED

Location _____

Rig up _____

Drilling and Remarks:

T. S. 2605

T. D. 2621

135 yds 24 hrs

38° Sw.

RECORD

Cased _____ in., _____ ft.

Sand _____

Gas _____

Oil _____

Total Depth _____

PRODUCTION

1st 24 hrs. Nat. _____

1st 24 hrs. after shot. _____

Gas _____ Cu. Ft.

Dry Hole _____

Abandoned _____

Date

DEC 22 1905

S. J. LEWIS

Scout