

Cowley

Map No. Kans Sec. 19 Twp. 32 R. 3E

Well No. 11 wate Farm


Carter Oil Company
100 ft 50. of no#8

~~70~~ 90 Ft. from N. Line

_____ Ft. from S. Line

_____ Ft. from E. Line

990 Ft. from W. Line

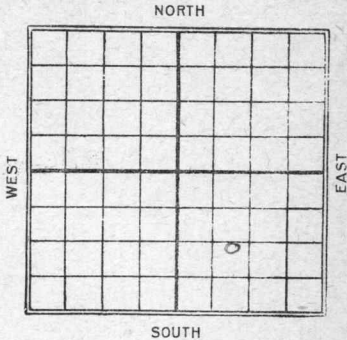

1926

| Date | REPORT |
|-------|---|
| 9/22 | Rig building |
| 9/29 | rig |
| 10/6 | Spud |
| 10/5 | Drlg 730 |
| 10/20 | " 1355 |
| 10/27 | " 1650 |
| 11/3 | " 2130' |
| 11/10 | Drlg 2405 |
| 11/17 | " 2615 |
| 11/24 | " 2790 |
| 12/1 | " 2900 |
| 12/8 | NO report |
| 12/15 | Drlg 3105' |
| 12/21 | " 3170 |
| 12/29 | " 3220 |
| 1927 | |
| 1/5 | Top sand 3425- T.D. 3430 200 bbls swabbed 24 hrs |

Map No. KANSAS Sec. 19 Twp. 32 R. 3E

Well No. 11 Waite

Carter Oil Company

Contractor

SECTION PLAT

| | | | |
|--|--|---|--|
| | | | |
| | | | |
| | | | |
| | | o | |

1090 Ft. from N. Line

_____ Ft. from S. Line

_____ Ft. from E. Line

990 Ft. from W. Line

FIRST REPORTS

Location _____

Rig up _____

Drilling and Remarks:

Rig building

RECORD

Cased _____ in., _____ ft.

Sand _____

Gas _____

Oil _____

Total Depth _____

PRODUCTION

1st 24 hrs. Nat. _____

1st 24 hrs. after shot _____

Gas _____ Cu. Ft.

Dry Hole _____

Abandoned _____

Date

SEP 22 1926

192

S. J. LEWIS

Scout

Cowley
KANSAS

Map No. _____ Sec. 19 Twp. 32 R. 3E

Well No. 11 Suite

Carta Oil Company

Contractor

SECTION PLAT

1090 Ft. from N. Line

_____ Ft. from S. Line

_____ Ft. from E. Line

990 Ft. from W. Line

COMPLETED

| | | | |
|--|--|--|--|
| | | | |
| | | | |
| | | | |
| | | | |
| | | | |

100 ft South of No 8

Location _____

Rig up _____

Drilling and Remarks:

T/S 3425

T/D 3430

*200 ft h. swab shot
24 hrs*

RECORD

Cased _____ in., _____ ft.

Sand _____

Gas _____

Oil _____

Total Depth _____

PRODUCTION

1st 24 hrs. Nat. _____

1st 24 hrs. after shot _____

Gas _____ Cu. Ft.

Dry Hole _____

Abandoned _____

Date

JAN 5 1927

S. J. LEWIS

Scout