


Map No. / *Kans* Sec. *19* Twp. *32* R. *3*

Well No. *I (A) Waite* Farm
7 B Slick Company

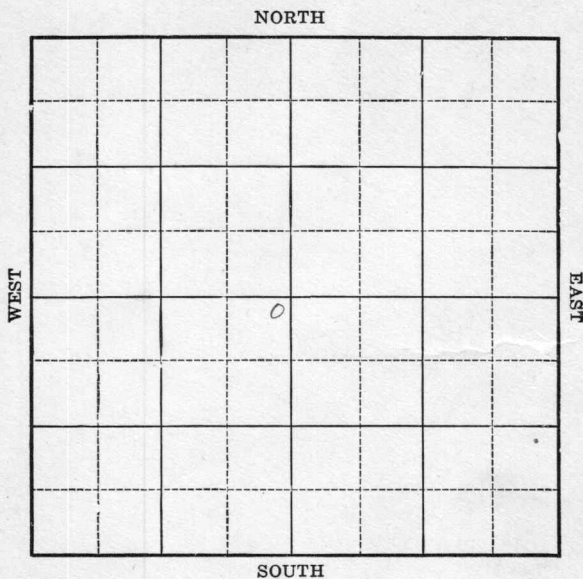

Location _____

Drilling Remarks _____

Rig Up _____

Drilling Remarks _____

RECORD

Cased _____ in. _____ ft.

Sand _____

Gas _____

Oil _____

Total Depth _____

PRODUCTION

1st 24 hrs. Nat. _____

1st. 24 hrs. after shot _____

Gas _____ cu. ft.

Dry Hole _____

Abandoned _____

Cowley

Map No. Kansas Sec. 19 Twp. 32 R. 3

Well No. XB Wants Farm

J. B. Slick Company


100 E #1

..... Ft. from N. Line

..... Ft. from S. Line

..... Ft. from E. Line

..... Ft. from W. Line

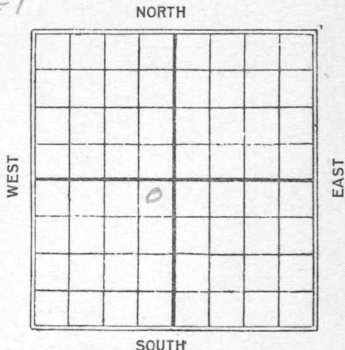

Beneas

Date	REPORT
1925	
2/8	R.O.G.
4/2	Dly 2640
7/5	fsg tools 2614
7/22	_____
7/29	_____
8/14	_____
8/14	UP 6" @ 2605
8/27	fsg tools 2605'
9/2	D. & G. 2605

Map No. **KANSAS** Sec. 19 Twp. 32 R. 2

Well No. I (A) Waite

J. B. Lick Company

Contractor

FIRST REPORT

SECTION PLAT

330 Ft. from N. Line

_____ Ft. from S. Line

330 Ft. from E. Line

_____ Ft. from W. Line

	o		

Location _____

Rig up _____

Drilling and Remarks:

*This well was
Camp, New Oelg.
to Wilcox sand,
Oelg. @ 2737'*

RECORD

Cased _____ in., _____ ft.

Sand _____

Gas _____

Oil _____

Total Depth _____

PRODUCTION

1st 24 hrs. Nat. _____

1st 24 hrs. after shot _____

Gas _____ Cu. Ft.

Dry Hole _____

Abandoned _____

Date

3/24 1925

M. A. BENEAR

Scout

Courtney

Map No. **KANSAS** Sec. 19 Twp. 32 R. 3E

Well No. 1B Hart

T.B. Slick Company

Contractor

SECTION PLAT

		o	<i>100 ft E No 1</i>

-----Ft. from N. Line

-----Ft. from S. Line

-----Ft. from E. Line

-----Ft. from W. Line

ABANDONED

Location # 1A

Rig up -----

Drilling and Remarks:

W 2605

D & a.

This should be

1A.

RECORD

Cased ----- in., ----- ft.

Sand -----

Gas -----

Oil -----

Total Depth -----

PRODUCTION

1st 24 hrs. Nat. -----

1st 24 hrs. after shot -----

Gas ----- Cu. Ft.

Dry Hole -----

Abandoned -----

Date

SEP 2 1925

192

S. J. LEWIS

Scout

MAP No. _____ SEC. 19 TWP. 32S R. 3E

WELL No. (A) Haint
Slick et al COMPANY

CONTRACTOR

SECTION PLAT

		0	

_____ FT. FROM N. LINE
 _____ FT. FROM S. LINE
 _____ FT. FROM E. LINE
 _____ FT. FROM W. LINE

RECORD

LOCATION _____

CASED _____ IN., _____ FT.

RIG UP _____

SAND _____

DRILLING AND REMARKS:

GAS _____

*4 string tools
in hole*

OIL _____

TOTAL DEPTH 76.14

PRODUCTION

1ST 24 HRS. NAT. _____

1ST 24 HRS. AFTER SHOT _____

GAS _____ CU. FT.

DRY HOLE

ABANDONED

DATE

9/3 1925 SCOUT

MAP No. _____ SEC. 19 TWP. 37S R. 3E

WELL No. 1 A. Vaite

Hick et al COMPANY

CONTRACTOR

SECTION PLAT

		o	

_____ FT. FROM N. LINE

_____ FT. FROM S. LINE

_____ FT. FROM E. LINE

_____ FT. FROM W. LINE

RECORD

LOCATION _____

CASED _____ IN. _____ FT.

RIG UP _____

SAND _____

DRILLING AND REMARKS:

GAS _____

3446-3440
Now gain 1/4"

OIL _____

TOTAL DEPTH 3440

PRODUCTION

1ST 24 HRS. NAT. _____

1ST 24 HRS. AFTER SHOT _____

GAS _____ CU. FT.

DRY HOLE ✓

ABANDONED ✓

DATE

12/14 1925

SCOUT