

O.W.W.O.

Greenwood

KANSAS

DX 78-1

Section 25 Township 27 Range 8E


Well No. #37 Lewis "A"

Company K.T. Weidemann Beaumont Petr. Co.

NORTH

WEST

EAST

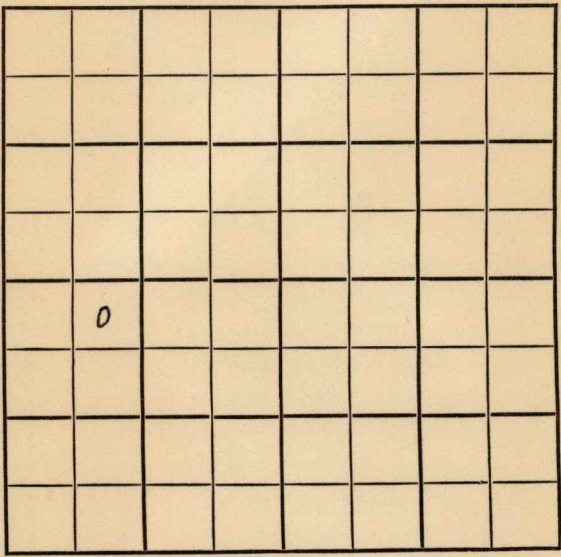

SOUTH

SEC.	TWP.	R.
25	27	8E

WELL NO. 37 Lewis FARM

COMPANY K. T. Weidemann

CONTRACTOR


Beaumont Pool

330 Ft. from N. Line

Ft. from S. Line

Ft. from E. Line

830 Ft. from W. Line

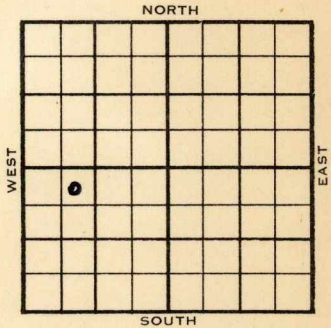

NE NW SW

1954	ELEVATION 1438'	REPORT
------	--------------------	--------

9/15
 D&A - TD 2802'
 Miss 2432', Arb. 2767'
 DST 2766-2802', 45", 1800' sli
 OCSW, BHP 840#
 TD 2802'
 D&A

FIRST REPORT
 ↓
ABANDONED

Co.

County Greenwood Co. Elev. 1438
 Sec. 25 Twp. 27 Rgs. 8E
 Company Beaumont Pet. Co.
 Farm Name Lewis "A" No. 37

TOPS	DEPTH	LOG	DATUM	Loc. in Sec.
Anb.				NE NW SW
TP.				(OWWO)
H.				
Tr.				
Dg.				
Bl.				
L.				Geol.
K.C.				Contr.
B.K.C.				
Ce.				
C.				
M.		2132		Pool
M.				Beaumont
K.				
Mz.				
Me.				
V.				
S.				
S.				
A.		2767		ABANDONED
R.				
PE.				
G.				
TD.		2802		DEC 26 '56

Date Comm. New Info. to wash down for SWDW DEC 12 '56 ✓
DEC 19 '56 ✓ DEC 26 '56 DD 2997
complete for SWD well

R

O.W.W.O.

FORM 513 SUNRAY

County Greenwood Co. Elev. 1438
 Sec. 25 Twp. 27 Rge. 8E
 Company Beaumont Pet. Co.
 FarmName Lewis "A" No. 37

TOPS	DEPTH	LOG	DATUM	Loc. in Sec.
Anh.				NE NW SW
TP.				(OWWO)
H.				
Tr.				
Dg.				
Bl.				
L.				Geol.
K.C.				Contr.
B.K.C.				
Ce.				
C.				
M.		2432		Pool
M.				Beaumont
K.				
Mz.				
Mq.				
V.				
S.				
S.		2757		FIRST REPORT
A.				
R.				
PE.				
G.				
T.D.		2802		

Date Comm. OTD 2802
 New Info. to wash down for SWDW

~~30~~

Co.
Lse.
No.
Sec.
T.
R.

