




Cowley

Map No. Kansas Sec. 19 Twp. 32 R. 3E

Well No. 1 B Waite Farm

J. B. Slick Company

NORTH

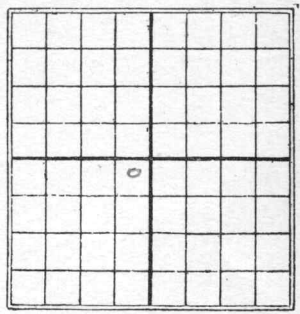

..... Ft. from N. Line

..... Ft. from S. Line

..... Ft. from E. Line

..... Ft. from W. Line

75 feet E 1<sup>A</sup> SOUTH

Date

REPORT

<u>9/25</u>	
<u>9/2</u>	<u>Location</u>
<u>9/9</u>	<u>skid rig</u>
<u>9/16</u>	<u>spec</u>
<u>9/24</u>	<u>Log @ 515'</u>
<u>9/30</u>	<u>✓ @ 1100</u>
<u>10/6</u>	<u>✓ @ 1300</u>
<u>10/13</u>	<u>✓ ✓ 1720</u>
<u>10/21</u>	<u>1960 set 10"</u>
<u>10/28</u>	<u>dry 2210'</u>
<u>11/4</u>	<u>✓ 2580</u>
<u>11/11</u>	<u>✓ —————</u>
<u>11/18</u>	<u>✓ 2805</u>
<u>9-8</u>	<u>dry 2 hand</u>
	<u>2.0. 3440'</u>



Map No. **KANSAS** Sec. 19 Twp. 32 R. 3E

Well No. 1B-Hait

T. B. Slick Company

Contractor

**SECTION PLAT**

		0	75 ft. E. of
		1A	

-----Ft. from N. Line

-----Ft. from S. Line

-----Ft. from E. Line

-----Ft. from W. Line

**FIRST REPORT**

Location -----

Rig up -----

Drilling and Remarks:

**RECORD**

Cased ----- in., ----- ft.

Sand -----

Gas -----

Oil -----

Total Depth -----

**PRODUCTION**

1st 24 hrs. Nat. -----

1st 24 hrs. after shot -----

Gas ----- Cu. Ft.

Dry Hole -----

Abandoned -----

Date

SEP 2 1925

S. J. LEWIS

Scout

Map No. **KANSAS** Sec. 19 Twp. 32 R. 3E

Well No. 1-B White

T. B. Blick Company

Contractor

**SECTION PLAT**

	0		
	75' Sand 1-A		

-----Ft. from N. Line

-----Ft. from S. Line

-----Ft. from E. Line

-----Ft. from W. Line

**ABANDONED**

Location -----

Rig up -----

Drilling and Remarks:

T 3440  
1-A

**RECORD**

Cased ----- in., ----- ft.

Sand -----

Gas -----

Oil -----

Total Depth -----

**PRODUCTION**

1st 24 hrs. Nat. -----

1st 24 hrs. after shot -----

Gas ----- Cu. Ft.

Dry Hole -----

Abandoned -----

Date

DEC 16 1925

S. J. LEWIS

Scout

1  
Map No. **KANSAS** Sec. 19 Twp. 32 R. 8E

Well No. 1-B White

T. B. Slick Company

Contractor

75' East 1A.

SECTION PLAT

	0		

----- Ft. from N. Line

----- Ft. from S. Line

----- Ft. from E. Line

----- Ft. from W. Line

**ABANDONED**

Location -----

Rig up -----

Drilling and Remarks:

TJ 3440  
J & F.

RECORD

Cased ----- in., ----- ft.

Sand -----

Gas -----

Oil -----

Total Depth -----

PRODUCTION

1st 24 hrs. Nat. -----

1st 24 hrs. after shot -----

Gas ----- Cu. Ft.

Dry Hole -----

Abandoned -----

Date

SEP 8 1921

S. J. LEWIS

Scout