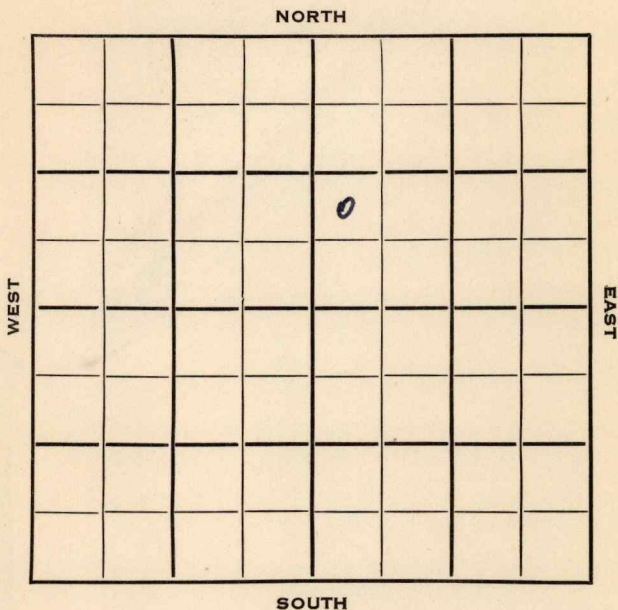


Section 25 Township 27 Range 8 EWell No. # 3 Lewis "C"Company K. T. Weidemann

Greenwood

KANSAS ✓

Sec. 25 Twp. 27 R. 8EWell No. #3 Lewis "C" FarmK.T. Weidemann

Company

Weidemann

Contractor

Beaumont


Ft. from N. Line

990 Ft. from S. Line

Ft. from E. Line

330 Ft. from W. Line

NW SW NE

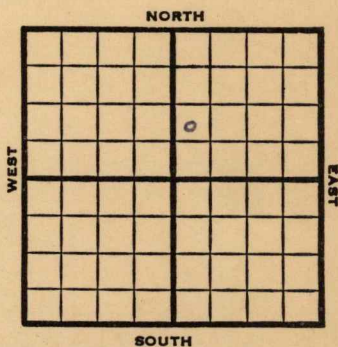

1953

Elev. -

REPORT

7/14

Spud 7-6-53

10" @ 21'

RTD 2448'

7" @ 2442'

in Miss Ls

WOCT

8/12

Spud 7-6-53

Oil Well

TD 2458

10" @ 21

7" @ 2442

Miss 2425

TD 2448

DD 2458, 1500A

Comp. 10 bopd 15 bw

COMPLETED

County Greenwood State KansasSec. 25 (Blk. Twp.) 27 (Sur. Rge.) 8E Map No.Operator K. T. WeidemannWell No. 3 Farm Lewis "C"Elev. Location NW SW NE

FIRST REPORT

990 Ft. From S Line NE330 Ft. From W Line Quarter1st. Report JUL 14 1953

Completion

Remarks

Weidemann - Contr.Spudding Date 7-6-53Drlg. Data Beaumont10" @ 21' RTD 2448 7" @ 2442 in Miss ls
WOCT

J. G. McGEHEE

County Greenwood State Kansas

Sec. 25 (Blk. Twp.) 27 (Sur. Rge.) 8E Map No.

Operator K. T. Weidemann

Well No. 3 Farm Lewis "C"

Elev.	Location	NW	SW	NE


COMPLETE

990 Ft. From S Line NE

330 Ft. From W Line Quarter

1st. Report

Completion **AUG 12 1953**

Remarks	Beaumont Pool
---------	---------------

Weidemann - Contr.

Spudding Date 7-6-53

Drilg. Data Oil well TD 2458

10" @ 21 7" @ 2442 Miss. 2425

TD 2448 DD 2458 1500 A

Comp. 10 bopd 15 bw

J. C. McGEHEE