

Map No. 174N Sec. 20 Twp. 32 R. 9E

Well No. 1 East Carson Farm

T. B. Slick Company

WEST

EAST

SOUTH

Rig Up

Drilling Remarks

PRODUCTION

1st 24 hrs. Nat.-----

1st 24 hrs. after shot-----

Gas _____ cu. ft.

Dry Hole

Abandoned -----

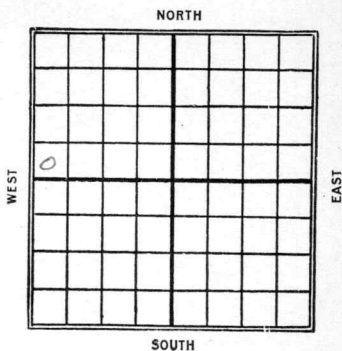
Cowley

Map No. Kansas Sec. 20 Twp. 32 R. 3EWell No. 1 East Carson FarmJ.B. Slick Company

Ft. from N. Line

250 Ft. from S. Line

Ft. from E. Line

250 Ft. from W. Line

Date	REPORT
1926	
6/30	Rig
4/14	Rigging up
7/22	Drig 250
8/11	" 1560
8/18	" 1840
8/25	" 1925
9/1	" 2230
9/8	" 2305
9/15	I.L. 2305, rig pulled building new rig
9/22	Drig 2450'
9/29	" 2835
10/6	" 2960
10/13	I.L. 2960-fishing
10/20	I.L. 3250 fishing
10/27	same
11/3	same
11/10	same
11/17	same
11/24	—
12/1	—
12/8	—

12/15 - Run 5" at 3180' Drlg by tools
12/21 - same
12/29 -
1927
1/5 -
1/12 - Rigging up company's tools
1/19 - Pulled 5" - 6" - & 8" to str. ream.
1/26 - str. ream 2480
2/2 - T.D. 2480 - fishing
2/9 - same
2/16 - Drlg 3190
2/23 - " 3200
3/2 - T.D. 3207 - drlg up iron
3/9 - Drlg 3227
3/16 - T.D. 3260 - drilling up
bailer
3/23 -
3/30 - T.D. 3260 - fishing bailer
4/6 -
4/13 - T.D. 3260 - fishing tools
4/20 - T.D. 3262 fishing tools
4/27 -
5/4 - Drlg 3415
5/11 - J x a 3569

K1 *Country*
 Map No. **KANSAS** Sec. *20* Twp. *32* R. *3E*

Well No. *1 East & Carson**T. B. Shick* Company

Contractor

SECTION PLAT

Ft. from N. Line

250 Ft. from S. Line

Ft. from E. Line

250 Ft. from W. Line

0			

FIRST REPORTS

Location

Rig up

Drilling and Remarks:

Rig

RECORD

Cased _____ in., _____ ft.

Sand _____

Gas _____

Oil _____

Total Depth _____

PRODUCTION

1st 24 hrs. Nat. _____

1st 24 hrs. after shot _____

Gas _____ Cu. Ft.

Dry Hole _____

Abandoned _____

Date

JUN 30 1926

192

S. J. LEWIS

Scout

Map No. KANGAS Sec. 20 Twp. 32 R. 3E

Well No. 1 East Carson

T. B. Slick Company

Contractor

SECTION PLAT

_____ Ft. from N. Line

250 Ft. from S. Line

_____ Ft. from E. Line

250 Ft. from W. Line

ABANDONED

Location _____

Rig up _____

Drilling and Remarks:

Base line 3420

Wilcox 3560 HFAW

TD 3564

THA

RECORD

Cased _____ in., _____ ft.

Sand _____

Gas _____

Oil _____

Total Depth _____

PRODUCTION

1st 24 hrs. Nat. _____

1st 24 hrs. after shot _____

Gas _____ Cu. Ft.

Dry Hole _____

Abandoned _____

Date

MAY 11 1927

S. J. LEWIS

Scout

MAP NO. _____ SEC. 20 TWP. 32S R. 3EWELL NO. 1 E Carson_____
COMPANY_____
CONTRACTOR

SECTION PLAT

0			

Ft. FROM N. LINE_____
Ft. FROM S. LINE_____
Ft. FROM E. LINE_____
Ft. FROM W. LINE

LOCATION _____

RIG UP _____

DRILLING AND REMARKS:

OK

RECORD

CASED _____ IN. _____ FT.

SAND _____

GAS _____

OIL _____

TOTAL DEPTH 3564

PRODUCTION

1ST 24 HRS. NAT. _____

1ST 24 HRS. AFTER SHOT _____

GAS _____ Cu. Ft.

DRY HOLE ✓ABANDONED ✓

DATE

5/11 1927

SCOUT