


Map No. _____ Sec. 25 Twp. 27 R. 8

Well No. 1 W. H. Lewis Farm

Empire Company

NORTH

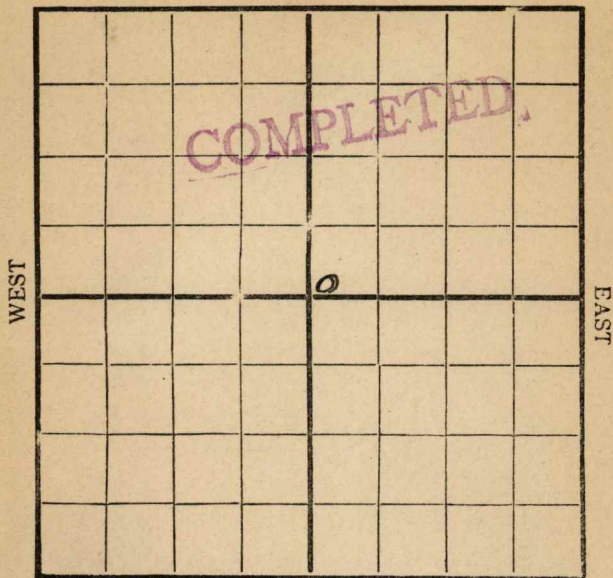

SOUTH

Location -----

Drilling Remarks:

Rig Up-----

Drilling Remarks:

RECORD

Cased_____ in_____Ft.

Sand -----

Gas _____

Oil -----

Total Depth_____

PRODUCTION

1st 24 hrs. Nat-----


1st 24 hrs. after shot-----

Gas_____Cu. Ft.

Dry Hole_____

Abandoned -----

Map No. _____ Sec. 25 Twp. 27 R. 8
 Well No. 1 W. H. Lewis Farm _____
Empire Company _____
 NORTH

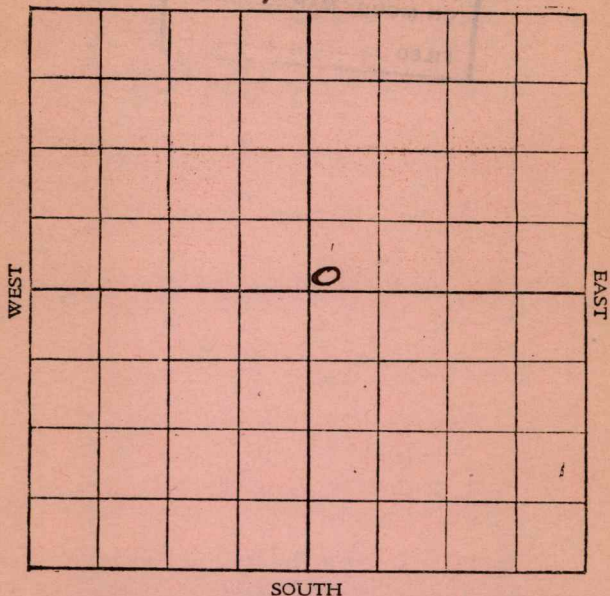

Location _____

Rig up _____

Drilling and remarks:

Loc.

RECORD

Cased _____ in. _____ Ft.

Sand _____

Gas _____

Oil _____

Total Depth _____

PRODUCTION

1st 24 hrs. Nat. _____

1st 24 hrs. after shot _____

Gas _____ Cu. Ft.

Dry Hole _____

Abandoned _____

Date

5/12, 1917 Brocker Scout


Greenwood

Map No. *K10* Sec. *25* Twp. *27* R. *8*

Well No. *1 W. H. Lewis* Farm

Emp. Company

NORTH

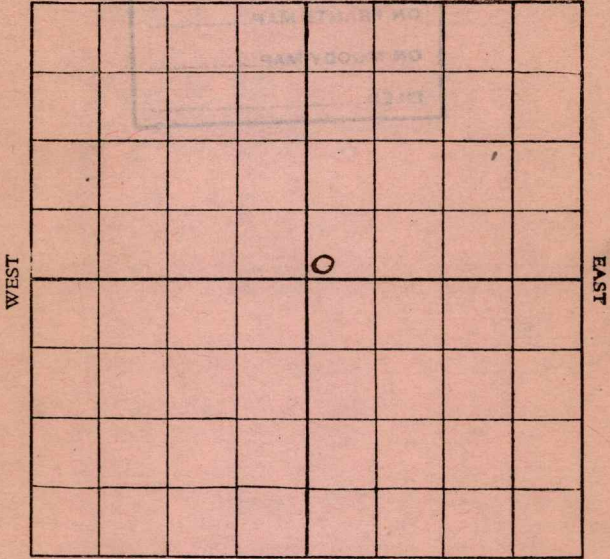

SOUTH

Location _____

Rig up _____

Drilling and remarks:

Loc.

RECORD

Cased _____ in. _____ Ft.

Sand _____

Gas _____

Oil _____

Total Depth _____

PRODUCTION

1st 24 hrs. Nat. _____

1st 24 hrs. after shot _____

Gas _____ Cu. Ft.

Dry Hole _____

Abandoned _____


Date

5/19, 191*7*, *Brocker* Scout

Map No. _____ Sec. 25 Twp. 27 R. 8Well No. 1 H. H. Lewis Farm _____Company Emp.

NORTH

WEST

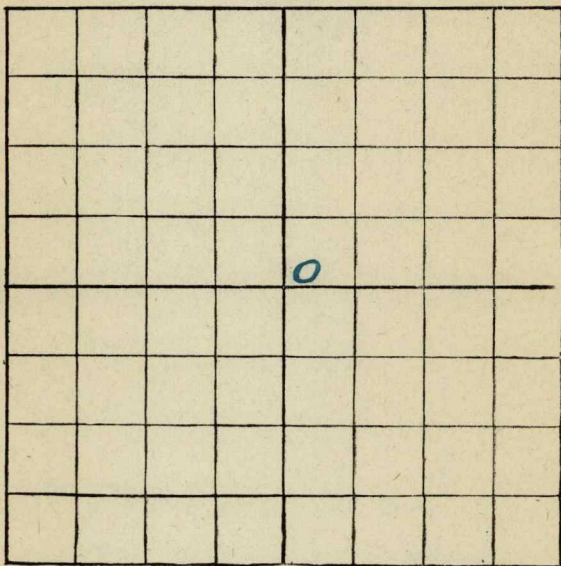

EAST

SOUTH

Location _____

Rig up _____

Drilling and remarks:

Loc.

RECORD

Cased _____ in. _____ Ft.

Sand _____

Gas _____

Oil _____

Total Depth _____

PRODUCTION

1st 24 hrs. Nat. _____

1st 24 hrs. after shot _____

Gas _____ Cu. Ft.

Dry Hole _____

Abandoned _____


Date

5/26, 1917, Drocker Scout

Greenwood

Map No. _____ Sec. 25 Twp. 27 R. 8Well No. 1 W. H. Lewis Farm _____Company Emp.

NORTH

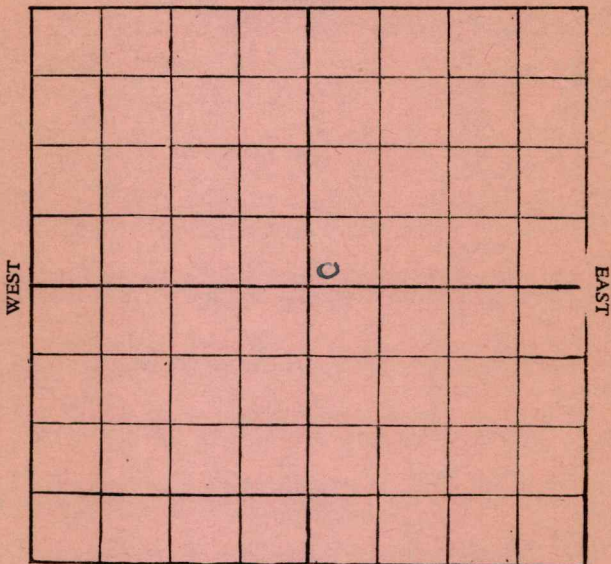

SOUTH

Location _____

Rig up _____

Drilling and remarks:

Loc.

RECORD

Cased _____ in. _____ Ft.

Sand _____

Gas _____

Oil _____

Total Depth _____

PRODUCTION

1st 24 hrs. Nat. _____

1st 24 hrs. after shot _____

Gas _____ Cu. Ft.

Dry Hole _____

Abandoned _____


Date

6/2, 1917, Brocker Scout

Greenwood

Map No. _____ Sec. 25 Twp. 27 R. 8Well No. 1 W. H. Lewis Farm __________
Emp. Company

NORTH

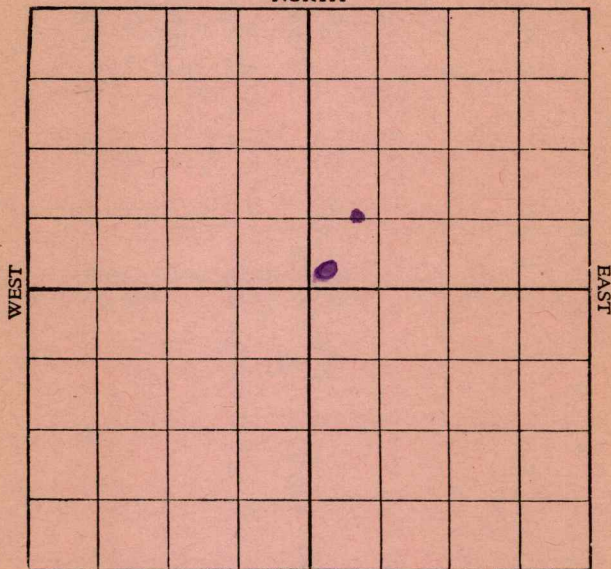

SOUTH

Location _____

Rig up _____

Drilling and remarks:

Loc

RECORD

Cased _____ in. _____ Ft.

Sand _____

Gas _____

Oil _____

Total Depth _____

PRODUCTION

1st 24 hrs. Nat. _____

1st 24 hrs. after shot _____

Gas _____ Cu. Ft.

Dry Hole _____

Abandoned _____

Date

JUN 9 - 1917


, 191

C. J. Lewis Scout

Greenwood

Map No. _____ Sec. 25 Twp. 27 R. 8Well No. 1 W. H. Lewis Farm_____Emp. Company

NORTH

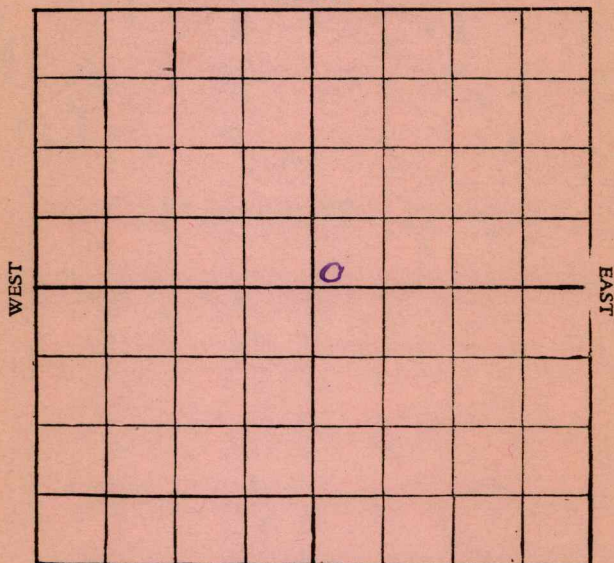

SOUTH

Location _____

Rig up _____

Drilling and remarks:

Loc.

RECORD

Cased _____ in. _____ Ft.

Sand _____

Gas _____

Oil _____

Total Depth _____

PRODUCTION

1st 24 hrs. Nat. _____

1st 24 hrs. after shot _____

Gas _____ Cu. Ft.

Dry Hole _____

Abandoned _____

Date

JUN 16 1917

C. T. Crocker


, 191

Scout

Greenwood

Map No. _____ Sec. 25 Twp. 27 R. 8Well No. 1 W. H. Lewis FarmEmp Company

NORTH

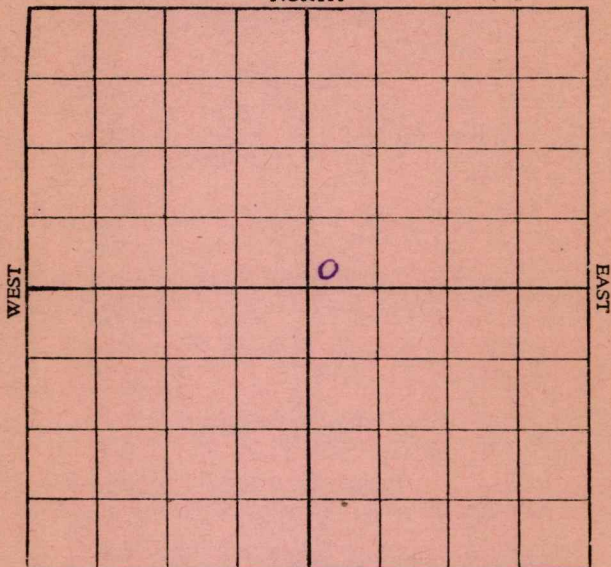

SOUTH

Location _____

Rig up _____

Drilling and remarks:

Loc.

RECORD

Cased _____ in. _____ Ft.

Sand _____

Gas _____

Oil _____

Total Depth _____

PRODUCTION

1st 24 hrs. Nat. _____

1st 24 hrs. after shot _____

Gas _____ Cu. Ft.

Dry Hole _____

Abandoned _____

Date


JUN 22 1917

, 191

C. J. Crocker Scout

Map No. _____ Sec. 25 Twp. 27 R. 8
 Well No. 1 W. J. Lewis Farm
Empire Company

NORTH

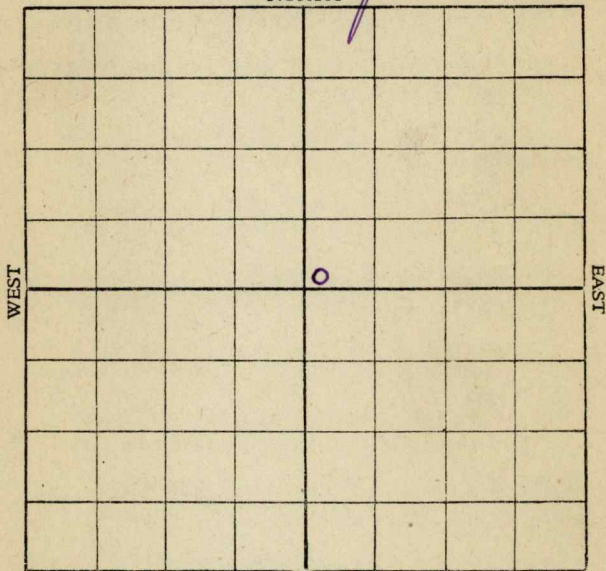

SOUTH

Location _____

Rig up _____

Drilling and remarks:

Loc.

RECORD

Cased _____ in. _____ Ft.

Sand _____

Gas _____

Oil _____

Total Depth _____

PRODUCTION

1st 24 hrs. Nat. _____

1st 24 hrs. after shot _____

Gas _____ Cu. Ft.

Dry Hole _____

Abandoned _____

Date JUN 30 1917

, 191


Scout

Greenwood

Map No. _____ Sec. 75 Twp. 27 R. 8Well No. 1 W H Lewis Farm

_____ Emp. _____ Company

NORTH

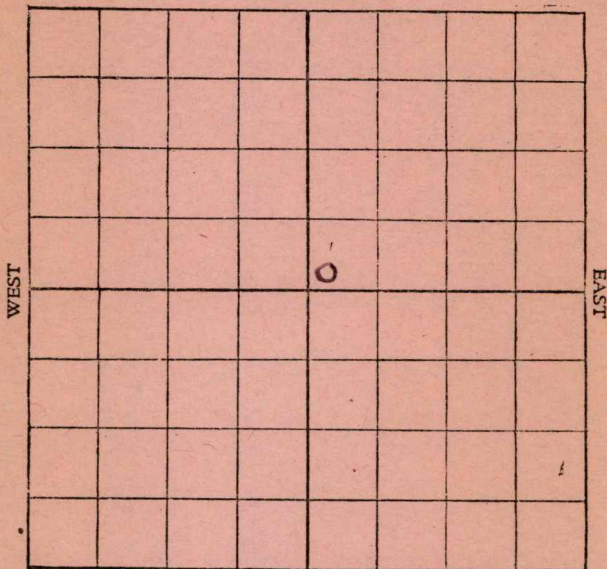

SOUTH

Location ✓

Rig up _____

Drilling and remarks:

RECORD

Cased _____ in. _____ Ft.

Sand _____

Gas _____

Oil _____

Total Depth _____

PRODUCTION

1st 24 hrs. Nat. _____

1st 24 hrs. after shot _____

Gas _____ Cu. Ft.

Dry Hole _____

Abandoned _____

Date

JUL 7 1917

191

G. V. Crocker.


Scout

Greenwood

Map No. _____ Sec. 25 Twp. 27 R. 8Well No. 1 W. H. Lewis Farm

Company

NORTH

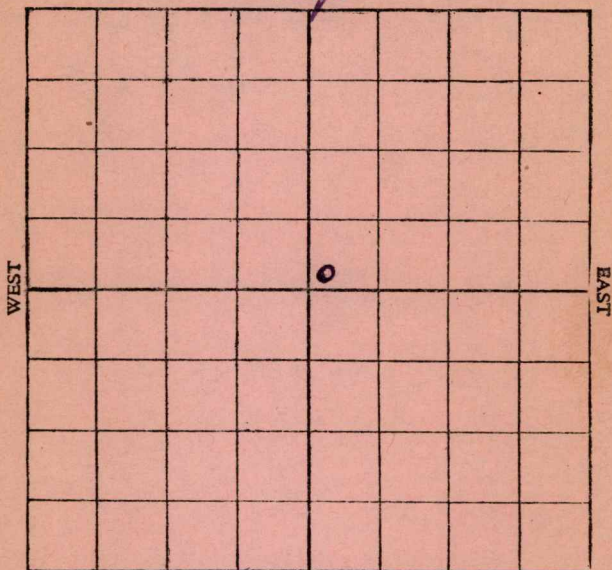

SOUTH

Location ✓

Rig up _____

Drilling and remarks:

RECORD

Cased _____ in. _____ Ft.

Sand _____

Gas _____

Oil _____

Total Depth _____

PRODUCTION

1st 24 hrs. Nat. _____

1st 24 hrs. after shot _____

Gas _____ Cu. Ft.

Dry Hole _____

Abandoned _____

Date

JUL 14 1917

191

G. J. Crocker
Scout

Map No. **K10** Sec. **25** Twp. **27** R. **8**Well No. **1. Lewis** Farm

Company

Greenwood NORTH

WEST

EAST

SOUTH

Location -----

Rig Up -----

Drilling and remarks

RECORD

Cased ----- in. ----- Ft

Sand -----

Gas -----

Oil -----

Total Depth -----

PRODUCTION

1st 24 hrs. Nat. -----

1st 24 hrs. after shot -----

Gas ----- Cu. Ft.

Dry Hole -----

Abandoned -----

Date

8-31-1917 **Lantz** Scout

Map No. _____ Sec. 25 Twp. 27 R. 8


Well No. 1. W. H. Lewis Farm _____

Empire Company _____

NORTH

WEST

EAST

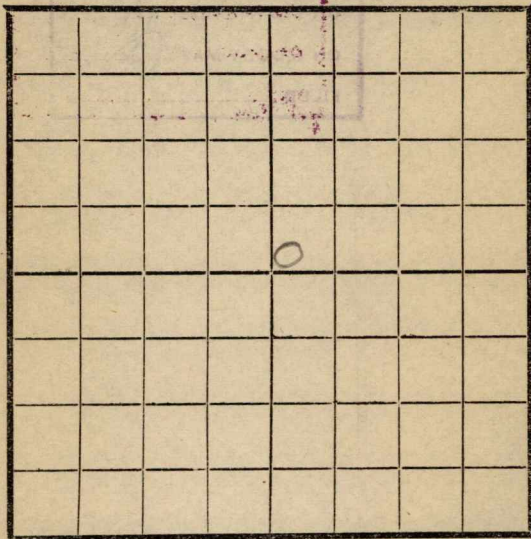

SOUTH

Location ☒ _____

Rig Up _____

Drilling and remarks _____

RECORD

Cased _____ in. _____ Ft.
 Sand _____
 Gas _____
 Oil _____
 Total Depth _____

PRODUCTION

1st 24 hrs. Nat. _____
 1st 24 hrs. after shot _____
 Gas _____ Cu. Ft.
 Dry Hole _____
 Abandoned _____

Date

9-5, 1917 _____ Scout


Map No. _____ Sec. 25 Twp. 27 R. 8

Well No. 1 Lewis Farm

Empire Company

NORTH

WEST

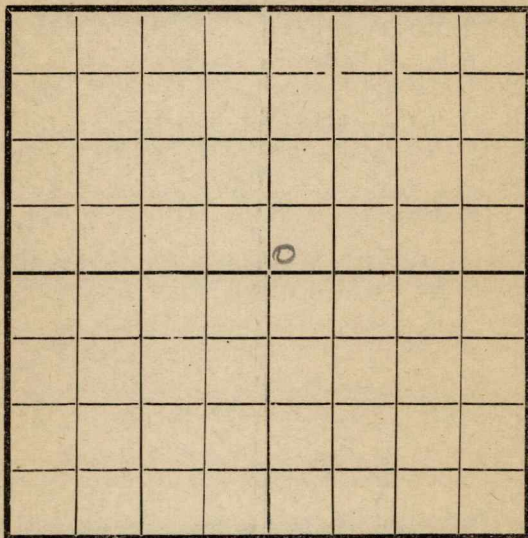

EAST

SOUTH

RECORD

Location ✓

Cased _____ in _____ Ft.

Rig Up _____

Sand _____

Drilling and remarks

Gas _____

Oil _____

Total Depth _____

PRODUCTION

1st 24 hrs. Nat. _____

1st 24 hrs. after shot _____

Gas _____ Cu. Ft.

Dry Hole _____

Abandoned _____

Date

11/29, 1917 Payle Scout

Map No. K10 Sec. 25 Twp. 27 R. 8Well No. 1 Lewis FarmEmpire Company

NORTH

WEST

EAST

SOUTH

Location ✓Rig Up ✓

Drilling and remarks

264' E of NL
264' N of SL

RECORD

Cased in. Ft.Sand Gas Oil Total Depth

PRODUCTION

1st 24 hrs. Nat. 1st 24 hrs. after shot Gas Cu. Ft.Dry Hole Abandoned

Date

1/28, 1918 J. Condy ScoutFirst Reprint

Map No. _____ Sec. 25 Twp. 27 R. 8Well No. Lewis Farm _____Carpenter Company _____

NORTH

WEST

EAST

SOUTH

Location _____

Rig Up _____

Drilling and remarks

RECORD

Cased _____ in. _____ Ft.

Sand _____

Gas _____

Oil _____

Total Depth _____

PRODUCTION

1st 24 hrs. Nat. _____

1st 24 hrs. after shot _____

Gas _____ Cu. Ft.

Dry Hole _____

Abandoned _____

Date

4/17, 1918 S. Cordiff Scout


Map No. _____ Sec. 25 Twp. 27 R. 8

Well No. 1 Lewis Farm _____

Angine Company _____

NORTH

WEST

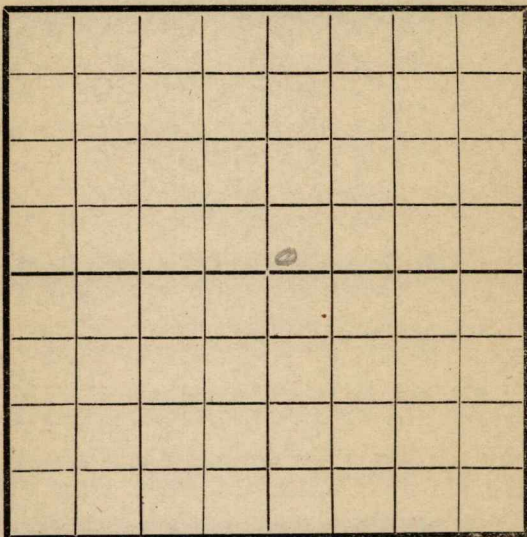

EAST

SOUTH

Location _____

Rig Up _____

Drilling and remarks

Spinning

RECORD

Cased _____ in. _____ Ft.

Sand _____

Gas _____

Oil _____

Total Depth _____

PRODUCTION

1st 24 hrs. Nat. _____

1st 24 hrs. after shot _____

Gas _____ Cu. Ft.

Dry Hole _____

Abandoned _____


Date

4/24, 1911 S. C. C. C. Scout

Map No. _____ Sec. 25 Twp. 27 R. 8Well No. 1 Lewis Farm_____Emery Company

NORTH

WEST

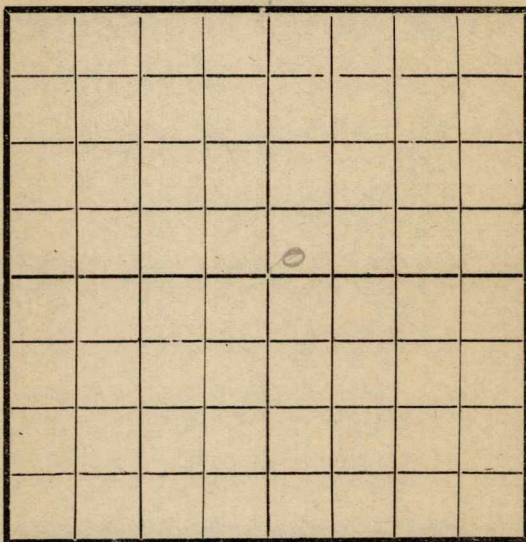

EAST

SOUTH

RECORD

Location _____

Cased _____ in. _____ Ft.

Rig Up _____

Sand _____

Drilling and remarks

Gas _____

Oil _____

Total Depth _____

PRODUCTION

1st 24 hrs. Nat. _____

1st 24 hrs. after shot _____

Gas _____ Cu. Ft.

Dry Hole _____

Abandoned _____


Date

5/1, 1918 Scout

Map No. _____ Sec. 25 Twp. 27 R. 8
 Well No. 1 Lewis Farm _____
Empire Company

NORTH

WEST

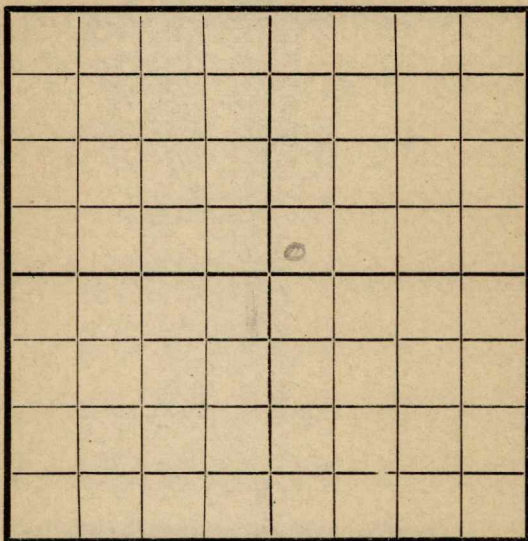

EAST

SOUTH

Location _____
 Rig Up _____
 Drilling and remarks

300

RECORD

Cased _____ in. _____ Ft.
 Sand _____
 Gas _____
 Oil _____
 Total Depth _____

PRODUCTION

1st 24 hrs. Nat. _____
 1st 24 hrs. after shot _____
 Gas _____ Cu. Ft.
 Dry Hole _____
 Abandoned _____

Date

5/8, 1918 S. Canby Scout


Map No. _____ Sec. 25 Twp. 27 R. 8

Well No. 1 Lewis Farm

Empire Company

NORTH

WEST

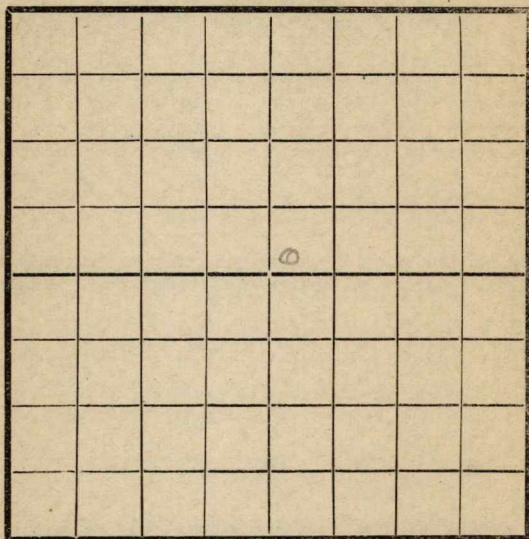

EAST

SOUTH

Location _____

Rig Up _____

Drilling and remarks

740

RECORD

Cased _____ in. _____ Ft.

Sand _____

Gas _____

Oil _____

Total Depth _____

PRODUCTION

1st 24 hrs. Nat. _____

1st 24 hrs. after shot _____

Gas _____ Cu. Ft.

Dry Hole _____

Abandoned _____


Date

5/15, 1918 S. Candy Scout

Map No. _____ Sec. 25 Twp. 27 R. 8Well No. 1 Lewis FarmCummins Company

NORTH

WEST

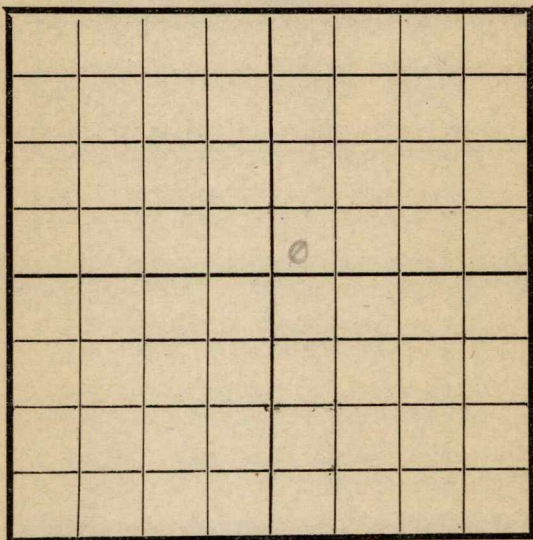

EAST

SOUTH

Location _____

Rig Up _____

Drilling and remarks

875

RECORD

Cased _____ in _____ Ft.

Sand _____

Gas _____

Oil _____

Total Depth _____

PRODUCTION

1st 24 hrs. Nat. _____

1st 24 hrs. after shot _____

Gas _____ Cu. Ft.

Dry Hole _____

Abandoned _____

Date

5/22/1918 Cummins Scout

Map No. _____ Sec. 25 Twp. 39 R. 8Well No. 1 Lewis Farm _____Company Empire

NORTH

WEST

EAST

SOUTH

RECORD

Location _____

Cased _____ in. _____ Ft.

Rig Up _____

Sand _____

Drilling and remarks

Gas 1112-1137

Oil _____

Total Depth _____

PRODUCTION

1st 24 hrs. Nat. _____

1st 24 hrs. after shot _____

Gas 6000000 Cu. Ft.

Dry Hole _____

Abandoned _____

Date

5/29, 1918 S. C. Cuddy Scout

Map No. _____ Sec. 25 Twp. 27 R. 8Well No. Levin


Company _____

Contractor _____

NORTH

WEST

EAST

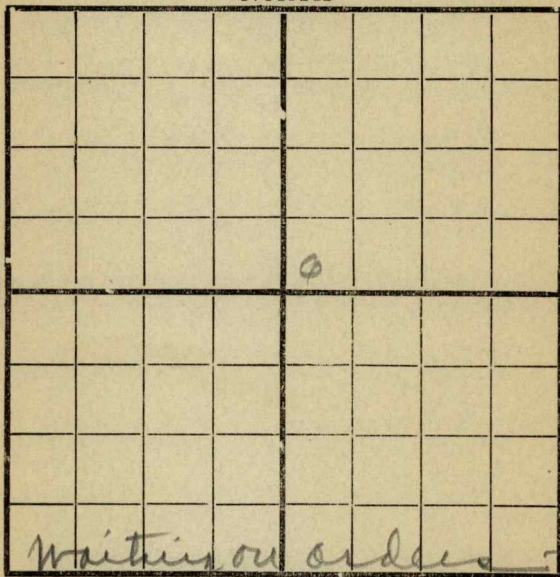

SOUTH

RECORD

Location _____

Cased _____ in., _____ ft.

Rig up _____

Sand 1112-1137

Drilling and Remarks:

Gas _____

Oil _____

Total Depth _____

PRODUCTION

1st 24 hrs. Nat. _____

1st 24 hrs. after shot _____

Gas _____ Cu. Ft.

Dry Hole _____

Abandoned _____

Date

6/5 191 S. C. Cady Scout

Map No. _____ Sec. 25 Twp. 27 R. 8Well No. 1 Lewis_____
Company_____
Contractor

NORTH

WEST

EAST

SOUTH

Location _____

Rig up _____

Drilling and Remarks:

1847

RECORD

Cased _____ in., _____ ft.

Sand _____

Gas _____

Oil _____

Total Depth _____

PRODUCTION

1st 24 hrs. Nat. _____

1st 24 hrs. after shot _____

Gas _____ Cu. Ft.

Dry Hole _____

Abandoned _____

Date


6/14 191 S. C. Cuddy

Scout

Map No. K10 Sec. 25 Twp. 27 R. 8Well No. Lewis FarmEmpire Company

NORTH

WEST

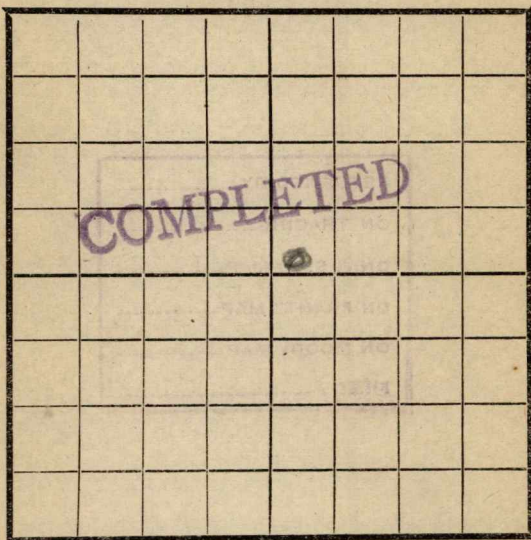

EAST

SOUTH

Location -----

Rig Up -----

Drilling and remarks

RECORD

Cased ----- in. ----- Ft.

Sand 1820-1847

Gas -----

Oil -----

Total Depth -----

PRODUCTION

1st 24 hrs. Nat. -----

1st 24 hrs. after shot -----

Gas ----- Cu. Ft.

Dry Hole -----

Abandoned -----

Date

6/14/8 Cardiff Scout

Map No. 419 Sec. 25 Twp. 27 R. 8Well No. 1 LewisEmpire CompanyBarber & Quinn of Empire Contractor

NORTH

WEST

EAST

COMPLETED

SOUTH

Location _____

Rig up _____

Drilling and Remarks:

Estimated
150 Barrels
daily

RECORD

Cased _____ in., _____ ft.

Sand 1820-1847

Gas _____

Oil _____

Total Depth _____

PRODUCTION

1st 24 hrs. Nat. _____

1st 24 hrs. after shot _____

Gas _____ Cu. Ft.

Dry Hole _____

Abandoned _____

Date

6/19 1918 C. Conley Scout