


Section 26 Township 32 Range 3-E

Well Number #1 Tinker

Company Wakefield et al

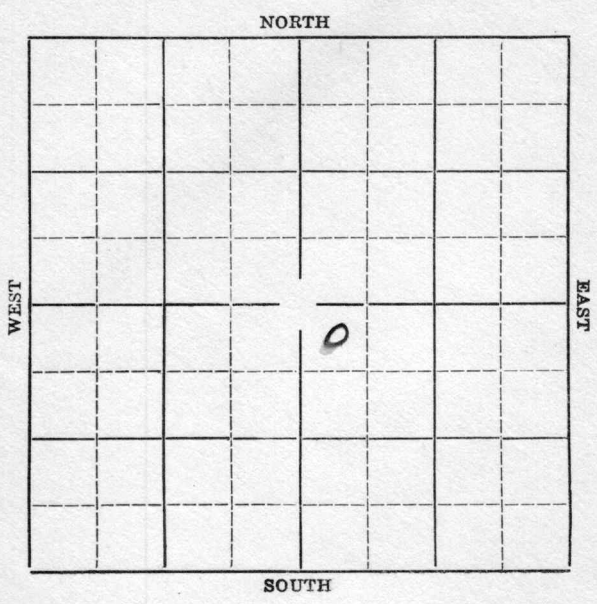

Sec. 26 Twp. 32 R. 3E

Well No. #1 Tinker Farm

Wakefield et al Company


330' Ft. from N. Line

_____ Ft. from S. Line

_____ Ft. from E. Line

330' Ft. from W. Line

Elev. 1188

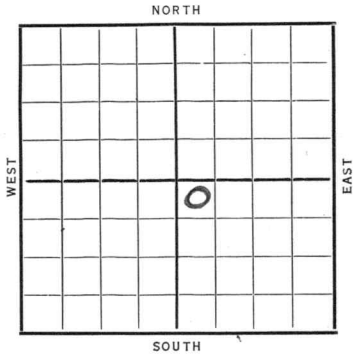

Date	REPORT
1936	
10/7	Location.
10/15	Rig on ground.
10/22	Rigging up.
10/29	20" @ 60'. Drlg. 525'.
11/6	Drlg. 1320
11/12	12" @ 1336 Drlg. 1375
11/19	10" @ 1877'. Drlg.
11/27	8" @ 2160'. T. D. 2240'.
	Underream 8".
12/3	Drlg. 3200'.
12/9	Sil. 3464
	HFW 3492 D&A
	TD <u>3495</u>
	COMPLETED

KANSAS

Cowley

Map No. 1 Sec. 26 Twp. 32 R. 3E7

Well No. 1 Timper

Hapeyfield & Co. Company

Contractor

SECTION PLAT

330 Ft. from N. Line

_____ Ft. from S. Line

_____ Ft. from E. Line

330 Ft. from W. Line

		0	

FIRST REPORT

Location ✓

Rig up _____

Drilling and Remarks:

RECORD

Cased _____ in., _____ ft.

Sand _____

Gas _____

Oil _____

Total Depth _____

PRODUCTION

1st 24 hrs. Nat. _____

1st 24 hrs. after shot _____

Gas _____ Cu. Ft.

Dry Hole _____

Abandoned _____

Date

OCT 7 1936 19

S. J. LEWIS Scout

Map No. 1 Sec. 26 Twp. 32 R. 3E

Well No. 1 Tinker

Hakerfield & Co Company

Contractor

SECTION PLAT

		0	

330 Ft. from N. Line

_____ Ft. from S. Line

_____ Ft. from E. Line

330 Ft. from W. Line

ABANDONED

Location _____

Rig up _____

Drilling and Remarks:

Sil 3464
N # W 3492

D & H

RECORD

Cased _____ in., _____ ft.

Sand _____

Gas _____

Oil _____

Total Depth 3495

PRODUCTION

1st 24 hrs. Nat. _____

1st 24 hrs. after shot _____

Gas _____ Cu. Ft.

Dry Hole _____

Abandoned _____

Date

DEC 9 1936 19 _____

S. J. LEWIS Scout