


Section 27 Township 32 Range 3E

Well No. #1 O'Neil


Company McKnabb

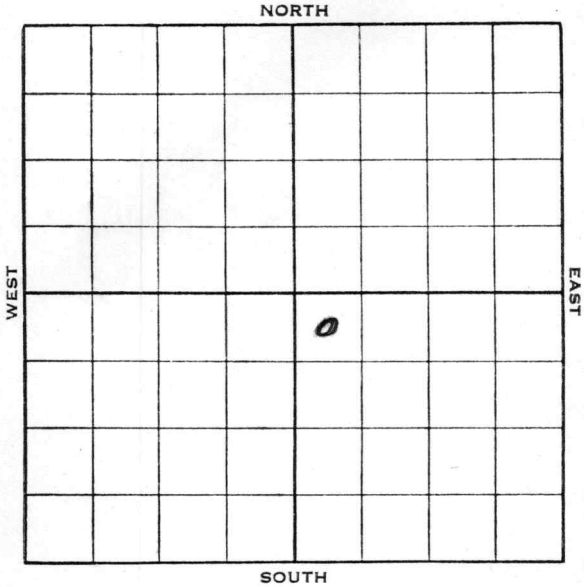

Sec. 27 Twp. 32 R. 3-E

Well No. #1 O'Neil Farm _____
McKnabb Company _____

330 Ft. from N. Line
 _____ Ft. from S. Line
 _____ Ft. from E. Line
330 Ft. from W. Line

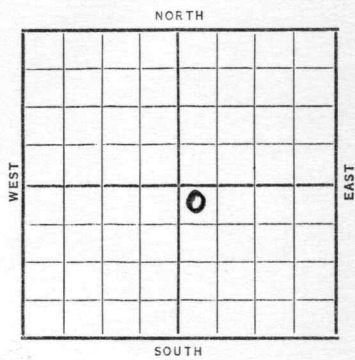

Date	REPORT
1938	
8/3	Drlg. 1000'.
8/12	" "
8/19	" "
8/26	Dlg. 2095'.
9/2	K. C. 2538'. Dlg. 2700'.
9/9	15" - 599'. 13" - 1364'.
	10" - 1878'. 8" - 2068'.
	S. S. O. 2768'. 6-5/8" - 2810'.
	Dlg. 2977'.
9/14	Miss. 3168'.
	Arb. 3526'.
	T. D. 3528'.
	H.F.W. 3526-28'.
	ABANDONED

Cowley

KANSAS

Map No. Sec. 27 Twp. 32 R. 3E

Well No. 1 O'Neil

McKnabb

Company

Contractor

FIRST REPORT

SECTION PLAT

NW SE

330 Ft. from N. Line

_____ Ft. from S. Line

_____ Ft. from E. Line

330 Ft. from W. Line

		0	

Location _____

Rig up _____

Drilling and Remarks:

Drlg. 1000

RECORD

Cased _____ in., _____ ft.

Sand _____

Gas _____

Oil _____

Total Depth _____

PRODUCTION

1st 24 hrs. Nat. _____

1st 24 hrs. after shot _____

Gas _____ Cu. Ft.

Dry Hole _____

Abandoned _____

Date

AUG 3 - 1938 19 H. D. Hatfield Scout

Map No. 1 Sec. 27 Twp. 32 R. 3E

Well No. 1 O'Neil

McKnab

Company

Contractor

ABANDONED

NW SE

SECTION PLAT

		0	

330 Ft. from N. Line

_____ Ft. from S. Line

_____ Ft. from E. Line

330 Ft. from W. Line

Location _____

RECORD

Rig up _____

Drilling and Remarks:

Cased _____ in., _____ ft.

Sand MISS 3168

Gas ARB 3526

Oil _____

Total Depth 3528

HFW 3526-28

PRODUCTION

1st 24 hrs. Nat. _____

1st 24 hrs. after shot _____

Gas _____ Cu. Ft.

Dry Hole _____

Abandoned _____

Date

SEP 14 1938 19

H. D. Hatfield

Scout

DVA