


Section 25 Township 27 Range 8E

Well No. 35 Lewis "A"

Company K. T. Weidemann

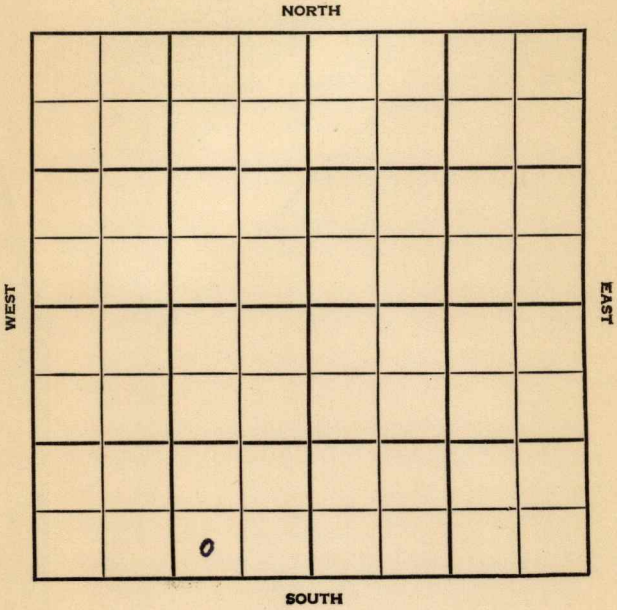

SEC.	TWP.	R.
25	27	8E



WELL NO. #35 Lewis "A" FARM

COMPANY K.T. Weidemann

CONTRACTOR


Beaumont Pool

_____ Ft. from N. Line

330 _____ Ft. from S. Line

990 _____ Ft. from E. Line

_____ Ft. from W. Line

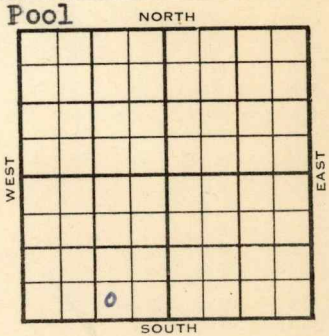

SW SE SW

1954	ELEVATION REPORT
5/12 6/9	Location Spudding 5-4-54 Oil well TD 2799 10" @ 35 B. Miss, 2695 Arb. 2744 TD 2799 5" @ 2799 6/ 2747-49 FU 1525' oil 17 hr. frac Comp. 25 bopd. <p style="text-align: center;">COMPLETED</p>

