

Cowley


O.W.W.O.

KANSAS

Section 29 Township 32 Range 3E

Well No. 1 Andes

Company ^{MARK} Broadbeck & Smitherman

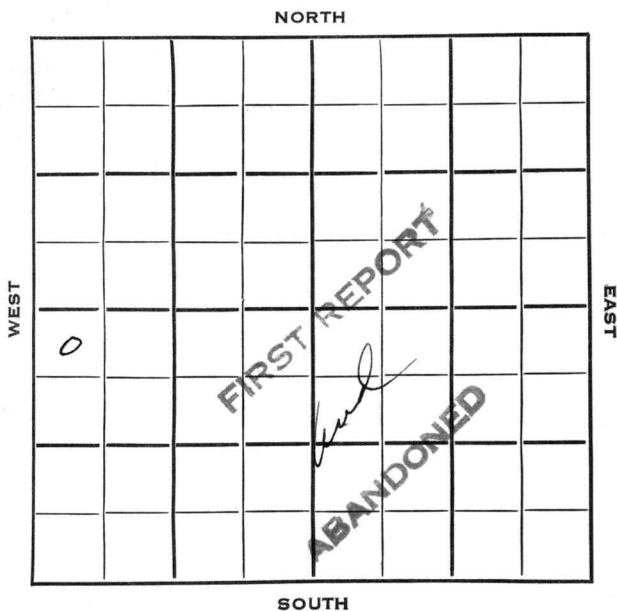

O.W.W.O.

Cowley KANSAS



Sec. 29 Twp. 32 R. 3 E

Well No. # 1 Andes Farm

MARK Broadbeck & Smitherman Company

Contractor

Wildcat


330 Ft. from N. Line

Ft. from S. Line

Ft. from E. Line

330 Ft. from W. Line

NW NW SW

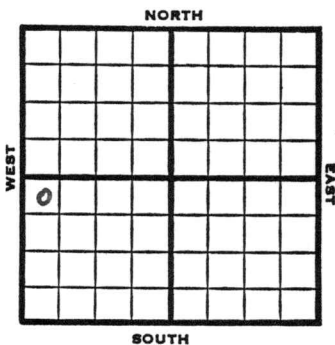

1953 Elev. -1133' REPORT

1/14 Bart 3130' Miss 3189'
TD 3200' D & A

FIRST REPORT
[Signature]
ABANDONED

O.W.W.O.

1954
623 Bart 3130', Miss 3189'
OTD 3200'
CO to set 5"

10/20 Bart 3130' Miss 3189' OTD 3200'
D & A

ABANDONED

County Cowley State Kansas

Sec. 29 (Blk. 32 (Sur. 3E (Twp.) (Rge.) Map No.

Operator Broadbeck & Smitherman

Well No. 1 Farm Andes

Elev. _____ Location NW NW SW



330 Ft. From N Line SW

330 Ft. From W Line Quarter

1st. Report JAN 14 1953

Completion JAN 14 1953

Remarks _____

Spudding Date _____

Drlg. Data Wildcat

Bart. 3130 Miss. 3189 TD 3200

D & A

O.W.W.O.

County **Cowley** State **Kansas**

Sec. **29** (Blk.) **32** (Sur.) **3E** Map No.

Operator **Mark Broadbeck**

Well No. **1** Farm **Andes**

Elev. **1133** Location **NW NW SW**

330 Ft. From **N** Line **SW**

330 Ft. From **W** Line **Quarter**

1st. Report **JUN 23 1954**

Completion

Remarks **O.W.W.O.**

Spudding Date **O.W.W.O.**

Drlg. Data

Bart. 3130 Miss. 3189 OTD 3200

CO to set 5"

