

Map No. *Kane* Sec. *30* Twp. *32* R. *3*

Well No. *1 Nebitt* Farm


Marland O. & R. Company

_____ Ft. from N. Line

930 Ft. from S. Line

_____ Ft. from E. Line

980 Ft. from W. Line

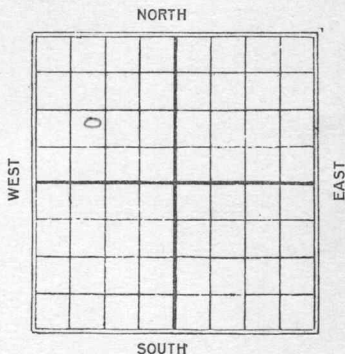

Beneas

Date
1924

REPORT

12/11 R. O. G.

12/17 Spudding.

1925

1/20 Sly 1900

1925

6/9 D + A bd 3582 T.L. 3162.

6/9 Top line 3162 D + A 3582

Map No. **KANSAS** Sec. 30 Twp. 32 R. 3

Well No. 1 Nebitt

Marland O & R Company

Contractor

FIRST REPORT

SECTION PLAT

_____ Ft. from N. Line

730 Ft. from S. Line

_____ Ft. from E. Line

980 Ft. from W. Line

o			

Location _____

Rig up _____

Drilling and Remarks:

R.O. G.

RECORD

Cased _____ in., _____ ft.

Sand _____

Gas _____

Oil _____

Total Depth _____

PRODUCTION

1st 24 hrs. Nat. _____

1st 24 hrs. after shot _____

Gas _____ Cu. Ft.

Dry Hole _____

Abandoned _____

Date

DEC 11 1924

192

M. A. BENEAR

Scout

Map No. 1 Sec. 30 Twp. 32 R. 3

Well No. 1 Nebitt

Marlond Company

Contractor

Abandoned

SECTION PLAT

0			
0			

_____ Ft. from N. Line

930 Ft. from S. Line

_____ Ft. from E. Line

980 Ft. from W. Line

Location _____

Rig up _____

Drilling and Remarks:

Tap L. 3162

D & A,

3582'

RECORD

Cased _____ in., _____ ft.

Sand _____

Gas _____

Oil _____

Total Depth _____

PRODUCTION

1st 24 hrs. Nat. _____

1st 24 hrs. after shot _____

Gas _____ Cu. Ft.

Dry Hole _____

Abandoned _____

Date

2/9 1925

MAR Scout

MAP No. _____ SEC. 30 TWP. 32S R. 3E

WELL No. 1 Newitt
Marland Oil COMPANY

CONTRACTOR _____

SECTION PLAT

o			

_____ FT. FROM N. LINE

_____ FT. FROM S. LINE

_____ FT. FROM E. LINE

_____ FT. FROM W. LINE

RECORD

LOCATION _____

CASED _____ IN., _____ FT.

RIG UP _____

SAND _____

DRILLING AND REMARKS:

GAS _____

OIL _____

TOTAL DEPTH 3528

JK

PRODUCTION

1ST 24 HRS. NAT. _____

1ST 24 HRS. AFTER SHOT _____

GAS _____ CU. FT.

DRY HOLE ✓

ABANDONED _____

DATE

4/9 1925

SCOUT