


Cowley

Section 33 Township 32 Range 3 E

Well No. # 1 Morris

Company McNish & Grallop

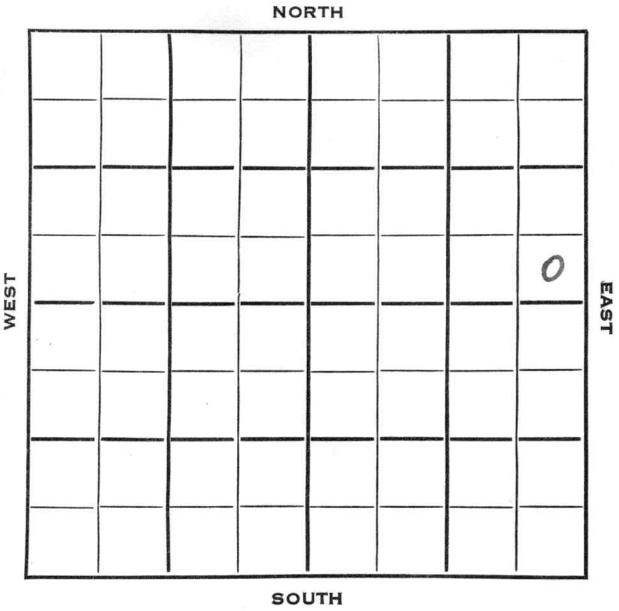

Cowley

KANSAS ✓

Sec. 33 Twp. 32 R. 3E

Well No. #1 Morris Farm

McNish & Grallop Company

Watson Drilling Contractor


 Ft. from N. Line

330 Ft. from S. Line

330 Ft. from E. Line

 Ft. from W. Line

SE SE NE

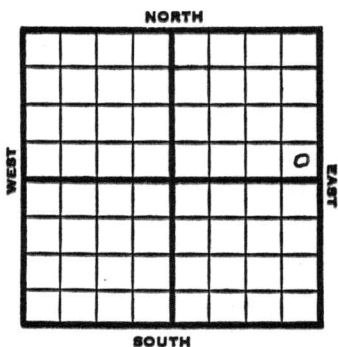

1952 Elev. 1167' REPORT

12/3 MIM

1953
1/14

Spud 12-22-52
D&A TD 3210
10" @ 100
Layton 2568, KC 2724, Miss
3198
TD 3210
D&A

ABANDONED

