


KANSAS

Map No. _____ Sec. 34 Twp. 32 R. 3E

Well No. 1-Test Farm _____

Lario O. & S. Company

NORTH

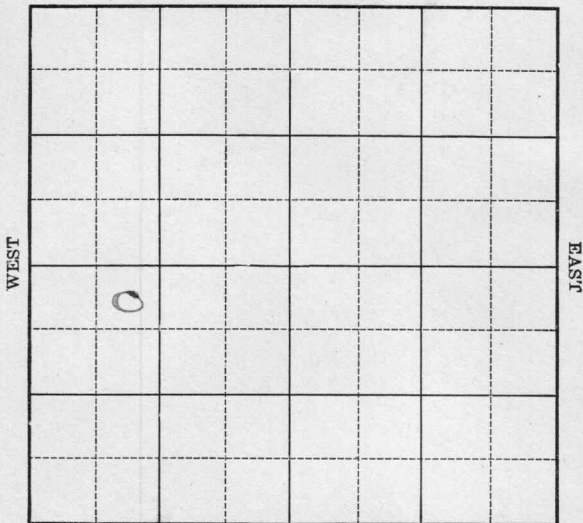

SOUTH

Location _____

Drilling Remarks _____

Rig Up _____

Drilling Remarks _____

RECORD

Cased _____ in. _____ ft.

Sand _____

Gas _____

Oil _____

Total Depth _____

PRODUCTION

1st 24 hrs. Nat. _____

1st 24 hrs. after shot _____

Gas _____ cu. ft.


Dry Hole _____

Abandoned _____

Map No. **KANSAS** Sec. **34** Twp. **32** R. **3E**

Well No. **1-Kent** Farm
Lario O. S. Company

NORTH

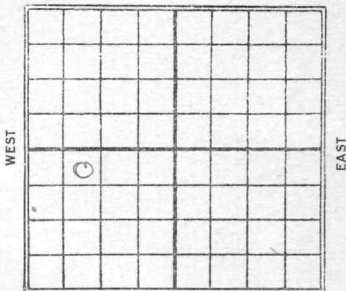

330 Ft. from N. Line

_____ Ft. from S. Line

_____ Ft. from E. Line

990 Ft. from W. Line

SOUTH

1928

Date

REPORT

7/3	Loc.
7/11	—
7/18	—
7/25	—
8/1	—
8/7	—
8/15	D. & A. location

K1

KANSAS

Map No. _____ Sec. 24 Twp. 32 R. 35

Well No. 1 Kent.

Lario O & G. Company

Contractor

SECTION PLAT

330 Ft. from N. Line

_____ Ft. from S. Line

_____ Ft. from E. Line

990 Ft. from W. Line

0			

FIRST REPORTS

Location ✓

Rig up _____

Drilling and Remarks:

RECORD

Cased _____ in., _____ ft.

Sand _____

Gas _____

Oil _____

Total Depth _____

PRODUCTION

1st 24 hrs. Nat. _____

1st 24 hrs. after shot _____

Gas _____ Cu. Ft.

Dry Hole _____

Abandoned _____

Date

JUL 3 1928

S. J. LEWIS

Scout

MAP No. Cowley **KANSAS** SEC. 34 TWP. 32 R. 3E

WELL No. 1 Kent

Lario O & G COMPANY

CONTRACTOR

SECTION PLAT

330 FT. FROM N. LINE

FT. FROM S. LINE

FT. FROM E. LINE

990 FT. FROM W. LINE

0			

ABANDONED

LOCATION ✓

RIG UP

DRILLING AND REMARKS:

D & A

RECORD

CASED _____ IN., _____ FT.

SAND _____

GAS _____

OIL _____

TOTAL DEPTH _____

PRODUCTION

1ST 24 HRS. NAT. _____

1ST 24 HRS. AFTER SHOT _____

GAS _____ CU. FT.

DRY HOLE _____

ABANDONED _____

DATE

AUG 15 1928

192

S. J. LEWIS

SCOUT