

KANSAS


FORM 51 5M 1-42 PETROL

Cowley

Section 35 Township 32 Range 3-E

Well No. #1. W. Orr

Company E. Wakefield

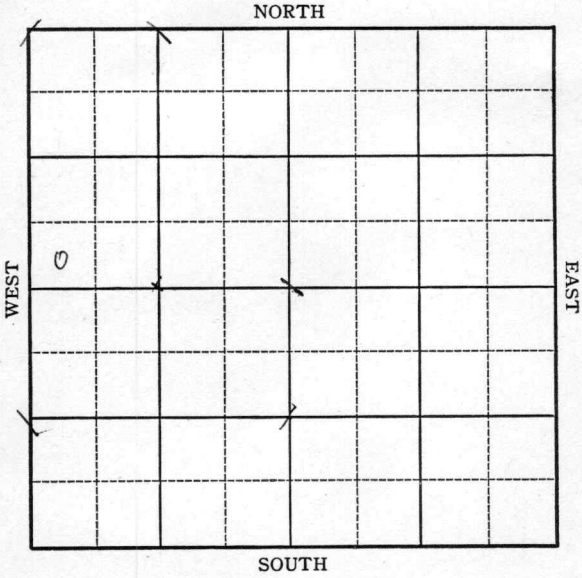

KANSAS

Cowley

Sec. 35 Twp. 32 R. 3-E

Well No. #1 W. Orr Farm

E. Wakefield Company

Miscellaneous


_____ Ft. from N. Line

660
330 Ft. from S. Line

_____ Ft. from E. Line

330 Ft. from W. Line

Elev. 1166

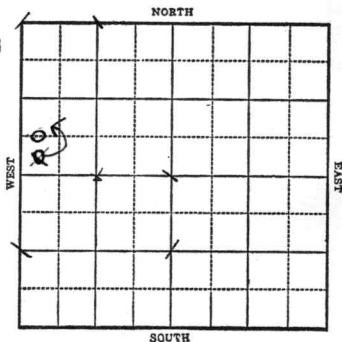

1943

R E P O R T

5/12 Location.

5/19 "

5/26 "

6/2 "

6/9 "

6/16 "

6/23 "

6/30 "

7/7 Rotary

7/15 8" @ 69'
Drlg. 1014'

7/21 Drlg. 2185'

7/28 Miss. 3196

T.D. 3212'

No shows.

ABANDONED

KANSAS

Cowley

Map No. _____ Sec. 35 Twp. 32 R. 3E


Well No. 1 W. Orr

E. Wakefield Company

FIRST REPORT Contractor

SW NW

SECTION PLAT

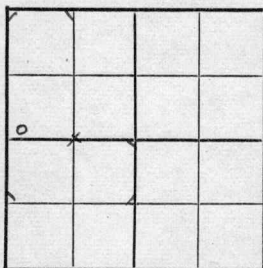

_____ Ft. from N. Line

330 Ft. from S. Line

_____ Ft. from E. Line

330 Ft. from W. Line

MISCELLANEOUS

Location XXX

Rig up _____

Drilling and Remarks:

RECORD

Cased _____ in., _____ ft.

Sand _____

Gas _____

Oil _____

Total Depth _____

PRODUCTION

1st 24 hrs. Nat. _____

1st 24 hrs. after shot _____

Gas _____ Cu. Ft.

Dry Hole _____

Abandoned _____

Date

MAY 1 2 1943

19

S. J. LEWIS

Scout

KANSAS

Map No. / Sec. 35 Twp. 32 R. 3E

Well No. 1 W. Orr

Earl Wakefield Company

CORRECTION Contractor

C W L SW NW
Ft. from N. Line
660 Ft. from S. Line
Ft. from E. Line
330 Ft. from W. Line

SECTION PLAT

4x4 grid section plat with a small 'd' in the second row, first column.

Misc.

Location

Rig up

Drilling and Remarks:

Reported

SW NW

RECORD

Cased in, ft.

Sand

Gas

Oil

Total Depth

PRODUCTION

1st 24 hrs. Nat.

1st 24 hrs. after shot

Gas Cu. Ft.

Dry Hole

Abandoned

Date

JUL 21 1943 19

S. J. LEWIS Scout

KANSAS

Map No. 1 Sec. 35 Twp. 32 R. 3E

Well No. 1 W. Orr

E. Wakefield Company

ABANDONED

Contractor

C WL SW NW

SECTION PLAT

o			

_____ Ft. from N. Line

660 Ft. from S. Line

_____ Ft. from E. Line

330 Ft. from W. Line

MISCELLANEOUS

Location _____

Rig up _____

Drilling and Remarks:

Miss 3195
Not known

RECORD

Cased _____ in., _____ ft.

Sand _____

Gas _____

Oil _____

Total Depth 3212

PRODUCTION

1st 24 hrs. Nat. _____

1st 24 hrs. after shot _____

Gas _____ Cu. Ft.

Dry Hole _____

Abandoned _____

Date

JUL 28 1943 19

S. J. LEWIS Scout