

COWLEY


KANSAS

DX 78-1

Section 1 Township 32 Range 4E

Well No. #1 Defore

Company O. A. Sutton

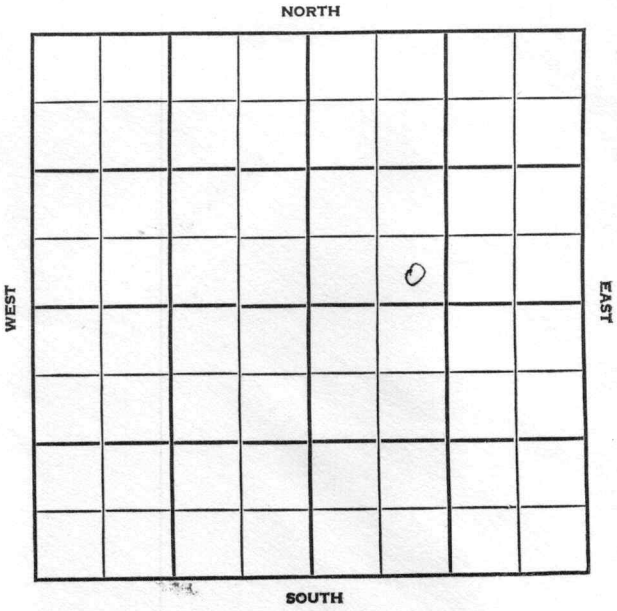

SEC. 1	TWP. 32	R. 4E
-----------	------------	----------


WELL NO. #1 Defore

COMPANY O. A. Sutton

CONTRACTOR Renfro

Tisdale Gas

_____ FT. FROM N. LINE
 _____ FT. FROM S. LINE
 _____ FT. FROM E. LINE
 _____ FT. FROM W. LINE

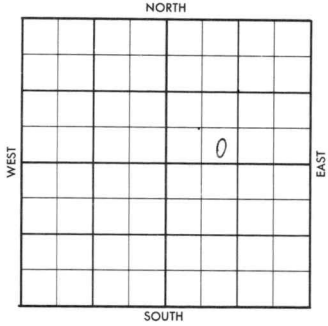

SE SW NE

1956	ELEVATION 1241'	REPORT
------	--------------------	--------

6-13
7-25

Location
 Comm. 6-19-56
 8 5/8" @ 95 w/70
 DST 2899-2927 op 90 min. gas to surf.
 in 15 min. rec. 26' GC&SOCM / 435' SM
 oil / 15' OCWM, BHP 1010/30".
 5 1/2" @ 2988 w/125
 60/2901-16
 FU 100' oil, 12 hrs.
 S/ 1/2 BOPH
 S/ 2 BOPH, no/wtr., 4 hrs.
 P/ 25 BOPD, no/wtr.
 Log tops: Stall. 1899'; Stall. sd. 1915
 Lay. 2325'; K0. 2443'; BKC 2540';
 Osw. 2682'; Cattle Sd. 2898';
 M. Chat 3040';
 TD 3056'

COMPLETED

County Cowley Elev. 1241
 Sec. 1 Twp. 32 Rge. LE
 Company O. A. Sutton
 Farm Name Defore No. 1

Co.

TOPS	DEPTH	LOG	DATUM
Anh.			
Tp. <u>stall</u>		<u>1899</u>	
H. <u>" sd</u>		<u>1915</u>	
Tr. <u>lay</u>		<u>2325</u>	
Dg.			
Bl.			
L.			
K.C.		<u>2443</u>	
B.K.C.		<u>2540</u>	
Ge. <u>osw</u>		<u>2682</u>	
t. <u>cailed</u>		<u>2898</u>	
M. <u>chat</u>		<u>3040</u>	
M.			
K.			
Mz.			
Mo.			
V.			
S.			
S.			
A.			
R.			
PE.			
G.			
T.D.	<u>3056</u>		

Loc. in Sec. SE SW NE

Geol. _____
 Contr. Renfro

Pool Tisdale Gas

COMPLETE			
JUL	25	1956	

Loc.

No.

Sec.

T.

R.

Date Comm.

Location JUN 20 '56 ✓ JUN 27 '56 6-19-56
8 5/8 95/70 DST 2899-2927
op 90" 9 to 5. 15" rec 26' GC
\$ 50 CM + 435' 5M oil + 15'
OCWM BHP 1010 130" 5 1/2 @ 2988
1125 JUL 3 '56 JUL 11 '56 JUL 18 '56 60/2901
-16 FU 100' oil 12 hrs \$ 1/2 Boph
1/2 + 2 Boph no/w 4 hrs
Frac. JUL 25 '56 P. 25 Boph no/w