


DX 78-1 Cowley

Section 1 Township 32S Range 4E

Well No. #3 Defore

Company Stewart Oil Co.

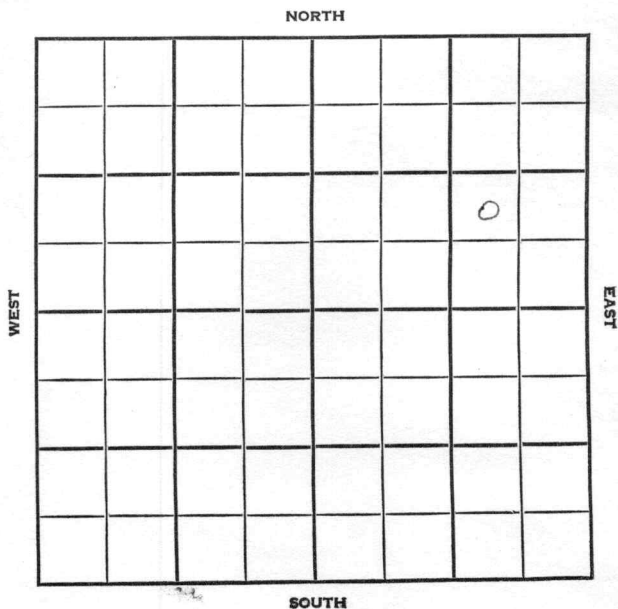

SEC. 1	TWP. 32	R. 4E
-----------	------------	----------

WELL NO.

#3 Defore

FARM

COMPANY

Stewart Oil Co.

CONTRACTOR

Renfro

Biddle NW

_____ FT. FROM N. LINE

_____ FT. FROM S. LINE

_____ FT. FROM E. LINE

_____ FT. FROM W. LINE

NW SE NE

							0		

NORTH

SOUTH

WEST

EAST

1956	ELEVATION 1244	REPORT
------	-------------------	--------

8-1 Location

9-5

Comm 8-13-56
~~Top~~ Log tops;
 Stal 1894, Stall Sd 1908, Lay 2314,
 KC 2438, BKC 2582, Ce 2796,
 Cattle Zn 2897, Cattle Sd 2900,
 Chat 3039
 TD 3055
 8 5/8" @ 103 w/75 Crd 2907-31
 90" G/22" rec 210' free oil +
 120" SMO + 180" VHOCM, 1075/20"
 5 1/2" @ 3030 /20" CO 2954 64/2907
 -23 FU 2100' oil 12 hrs
 4 BOPH BO no wtr 8 1/2 hrs
 POP
 Est P 25 BOPD no wtr

COMPLETED

County Cowley Elev. _____
 Sec. 1 Twp. 32S Rge. 4E
 Company Stewart Oil Co.
 Farm Name Defore No. 3

TOPS	DEPTH	LOG	DATUM	Loc. in Sec.
Anh.				NW SE NE
Tp.				
H.				
Tr.				
Dg.				
Bl.				
L.				Geol. _____
K.C.				Contr. _____
B.K.C.				
Ce.				Renfro
C.				
M.				Pool
M.				Biddle NW
K.				
Mz.				
Me.				
V.				
S.				
S.				
A.				
R.				
Pe.				
G.				
T.D.				



Date Comm. AUG 1 1956
 Loc. _____

AUG 5 1956

R.C.

[Handwritten signature]

Co.

Lse.

No.

Sec.

County Cowley Elev. 1244
 Sec. 1 Twp. 32S Rge. 4E
 Company Stewart Oil Co.
 Farm Name Defore No. 3

TOPS	DEPTH	LOG	DATUM	Loc. in Sec.
Anh.				NW SE NE
Tp. <u>stall</u>		<u>1894.</u>		
H. <u>" sd</u>		<u>1908</u>		
Tr. <u>lay</u>		<u>2314</u>		
Dg.				
Bl.				
L.				
K.C.		<u>2438</u>		Geol.
B.K.C.		<u>2582</u>		Contr.
Ce.		<u>2796</u>		
C. <u>Cattle Zn</u>		<u>2897</u>		<u>Renfro</u>
M. <u>" sd</u>		<u>2900</u>		
M. <u>chat</u>		<u>3029</u>		Pool
K.				<u>Biddle NW</u>
Mz.				
Ma.				
V.				
S.				
S.				
A.				
R.				
Pe.				
G.				
TR.	<u>3055</u>			

COMPLETE
 SEP 5 '56

Date Comm. Loc. AUG 8 '56 AUG 15 '56 8-13-56
8 5/8 103/75 D470 AUG 22 '56
erd 2907-31 Full rec.
DST 2897-2931 90" G/22" rec.
210' Free oil + 120' SMO + 180'
VHOCM 1075/20" 5 1/2 @ 3030
1200 AUG 29 '56 CO 2954 64/2907
-23 FU 2100' oil 12 hrs 4 BOPD
B0 no/w 8 1/2 hrs Pat SEP 5 '56
EST P. 25 BOPD no/wto.