


Section 29 Township 32 Range 3E
 Well No. #1 Rockwell
 Company Deardorf Oil Co.

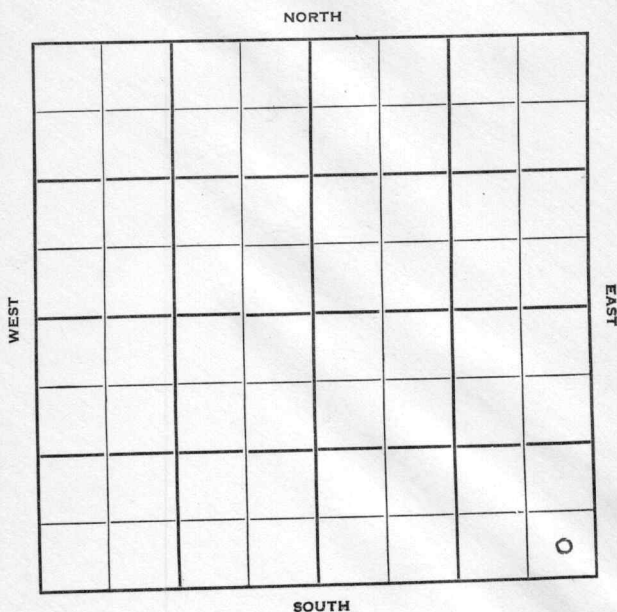

Cowley

KANSAS

SE

Sec. 29 Twp. 32 R. 3E

#1 Rockwell

Well No. Farm

Deardorf Oil Co.

Company

Wildcat

(Morrison Drlg., Contr.)

Ft. from N. Line


330'

Ft. from S. Line

330'

Ft. from E. Line

Ft. from W. Line

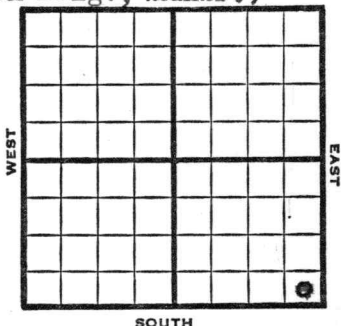

SE SE SE

1950

Elev 1172' REPORT

1/4

Set 10" @ 250'

WOC

2/1

TD 3605'

10" @ 250'

Simp 3590'

Arb. 3595'

No shows.

D&A

Aband.

ABANDONED

Kansas

Wildcat

Map No. _____ Sec. 29 Twp. 32 R. 3EWell No. 1 Rockwell

Deardorf Oil Co. _____ Company

Morrison Drlg. _____ Contractor

SE SE SE

SECTION PLAT



_____ Ft. from N. Line

330 Ft. from S. Line330 Ft. from E. Line

_____ Ft. from W. Line

Cowley County

Location _____

Rig up _____

Drilling and Remarks:

Set 10" @ 250

W O C

RECORD

Cased _____ in., _____ ft.

Sand _____

Gas _____

Oil _____

Total Depth _____

PRODUCTION

1st 24 hrs. Nat. _____

1st 24 hrs. after shot _____

Gas _____ Cu. Ft.

Dry Hole _____

Abandoned _____

Date

JAN 4 1950J.E. TYRA

Scout

Map No. _____ Sec. 29 Twp. 32 R. 3EWell No. 1 RockwellDear dorf Oil Co.

Company

Contractor

SE SE SE

E. 1172

SECTION PLAT

ABANDONED			
			0

_____ Ft. from N. Line

330 Ft. from S. Line330 Ft. from E. Line

_____ Ft. from W. Line

Cowley County

Location _____

Rig up _____

Drilling and Remarks:

10" @ 250Sings 3590and 3595no showsD & A.

RECORD

Cased _____ in., _____ ft.

Sand _____

Gas _____

Oil _____

Total Depth 3605

PRODUCTION

1st 24 hrs. Nat. _____

1st 24 hrs. after shot _____

Gas _____ Cu. Ft.

Dry Hole _____

Abandoned _____

Date

FEB 1 195019J. E. TYRA

Scout