


DX 78-1 Cowley

Section 1 Township 32 Range 4E

Well No. #3 Morris

Company O. A. Sutton

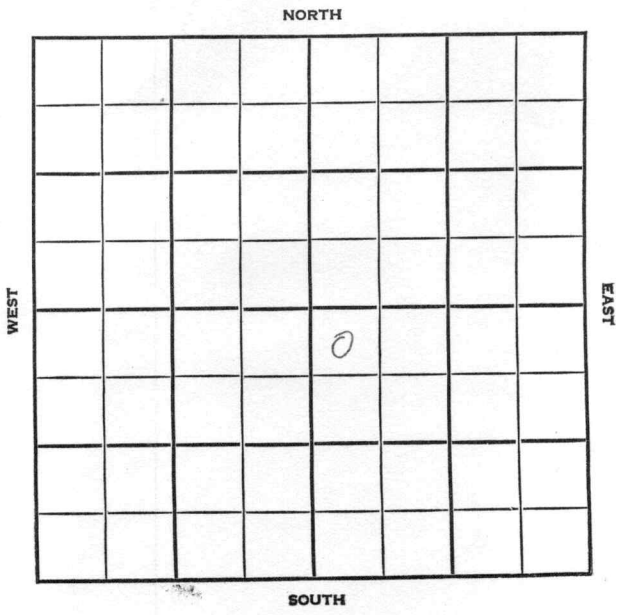

SEC. 1	TWP. 32	R. 4E
-----------	------------	----------

WELL NO. #3 Morris FARM

COMPANY O. A. Sutton

CONTRACTOR Renfro

NW Biddle

_____ FT. FROM N. LINE

_____ FT. FROM S. LINE

_____ FT. FROM E. LINE

_____ FT. FROM W. LINE

NW NW SE

1956	ELEVATION 1216'	REPORT
------	--------------------	--------

7-11 Comm. 7-7-56
8" @ 123 w/100
Drlg. 1890

7-25 DST 2900-05 op 2 hrs., 540' gas, rec.
30' HOCM, BHP 190#.
5 1/2" @ 2899 w/50
CO 2905
B/ 5 GO, 1 hr.,
FU 140' oil, 12 hrs.
S/ 3 BO ## / 2 BWP, 10 hrs.,
P/ 25 BO / 20 BW, 24 hrs.
Log tops:
Stall. 1882'; Stall. Sd. 1897';
Lay. Sd. 2307'; KC. 2433'; Osw. 2672';
Cahle. 2898'
TD 2905'

COMPLETED

29

County Cowley Elev. _____
 Sec. 1 Twp. 32 Rge. 14E
 Company O. A. Sutton
 Farm Name Morris No. 3

Co.
Lse.
No.
Sec.
T.
R.

TOPS	DEPTH	LOG	DATUM
Anh.			
Tp.			
H.			
Tr.			
Dg.			
Bl.			
L.			
K.C.			
B.K.C.			
Ce.			
C.			
M.			
M.			
K.			
Mz.			
Mq.			
V.			
S.			
S.			
A.			
R.			
Pe.			
G.			
T.D.			

Loc. in Sec. NW NW SE
 Geol. _____
 Contr. Renfro
 Pool NW Biddle

FIRST REPORT
 0
 JUL 11 '56

Date Comm. 7-7-56
8" @ 123/100 drlg. 1890

JUL 1 1956

R.G.

County Cowley Elev. 1216
 Sec. 1 Twp. 32 Rge. 1E
 Company A. Sutton
 Farm Name Morris No. 3

TOPS	DEPTH	LOG	DATUM	Loc. in Sec.
Anh. <u>Stall</u>		<u>1882</u>		NW NW SE
Tp. <u>" sd</u>		<u>1897</u>		
H. <u>624 sd</u>		<u>2307</u>		
Tr.				
Dg.				
Bl.				
L.				Geol.
K.C.		<u>2433</u>		
B.H.C. <u>05W</u>		<u>2672</u>		Contr.
Ce. <u>CAHLE</u>		<u>2898</u>		<u>Ranfro</u>
C.				
M.				Pool
M.				<u>NW Biddle</u>
K.				
Mz.				
Ma.				
V.				
S.				
S.				
A.				
R.				
Pe.				
G.				
T.D.	<u>2905</u>			

COMPLETE
 JUL 25 1956

Date Comm. 7-7-56
8" @ 123/100 drlg. 1890 JUL 18 '56

DST 2900-05 2 hrs 540' gae
see 30' HOCM BHP 190'
5 1/2 @ 2899/50 JUL 25 '56 CO 2905
1/2 5 GO 1 hr FU 140' oil
12 hrs 1/4 FRAC \$ 3 BOT
2 Bwph 10 hrs P. 25 BO
+ 20 BW 24 hrs