


Section 1 Township 32 Range 4E

Well No. #2 Blanche Morris

Company Texas Company

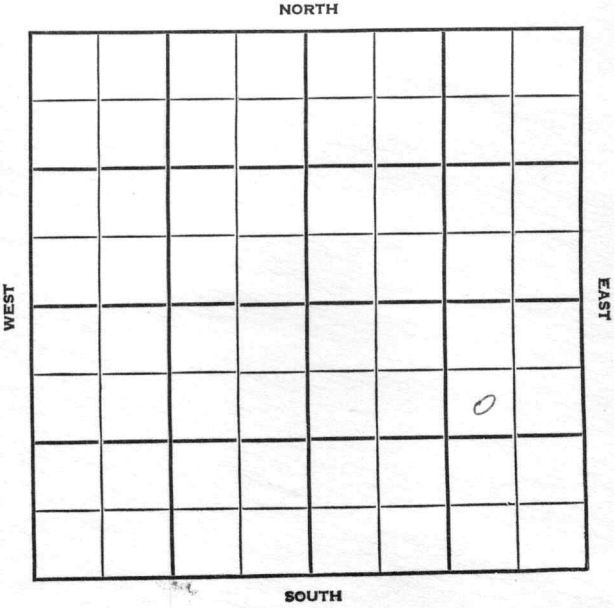

SEC. 1	TWP. 32	R. 4E
-----------	------------	----------


WELL NO. #2 Blanche Morris FARM

COMPANY Texas Company

CONTRACTOR Wakefield

NW Biddle

_____ FT. FROM N. LINE
 _____ FT. FROM S. LINE
 _____ FT. FROM E. LINE
 _____ FT. FROM W. LINE

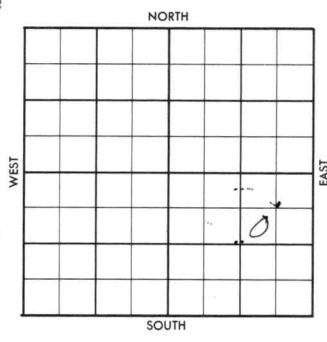

SW NE SE

1956	ELEVATION 1225'	REPORT
------	--------------------	--------

8-8 Comm. 8-1-56
 10" @ 120 w/100
 WOC

8-29 7" @ 3082 w/200
 CO 3048
 18/2902-08 ; tst 7 GO, no wtr., 90 min.
 Flwd 50 GO, no wtr. 6 hrs., 3/8" chk/
 TP 40#; SI
 Flw 80 BO , no/wtr., 5 hrs. / gas.
 Flw 25 BOPD no wtr., Grav. 37.7
 Stall. 1902'; Coun. gr. 2314';
 KC. 2422'; BKC 2572'; Oswego 2728';
 Skinner 2890'; Rd. Fk. 2977';
 M. 3037';
 TD 3083'

COMPLETED

County Cowley Elev. 1225

Sec. 1 Twp. 32 Rge. 4E

Company Texas Company


FarmName Blanche Morris No. 2

TOPS	DEPTH	LOG	DATUM
Anh.			
Tp.			
H.			
Tr.			
Dg.			
Bl.			
L.			
K.C.			
B.K.C.			
Ce.			
C.			
M.			
M.			
K.			
Mz.			
Mq.			
V.			
S.			
S.			
A.			
R.			
Pe.			
G.			
T.D.			

Loc. in Sec. SW NE SE

Geol. _____
 Contr. Wakefield

Pool NW Biddle

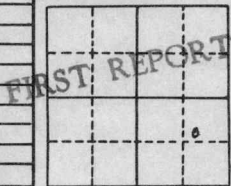

Date Comm. 8-1-56
10" @ 120/100 WOC

AUG 8 '56

AUG 1 1956

Handwritten signature/initials

Co.

Use.

No.

Sec.

T.

R.

County Cowley Elev. 1225
 Sec. 1 Twp. 32 Rgs. 4E
 Company Texas Company
 Farm Name Blanche Morris No. 2

TOPS	DEPTH	LOG	DATUM	Loc. in Sec.
Anh.				SW NE SE
TP. <u>Stall</u>	<u>1902</u>			
H. <u>Cowley</u>	<u>2314</u>			
Tr.				
Dg.				
Bl.				
L.				Geol.
K.C.	<u>2422</u>			
B.K.C.	<u>2572</u>			Contr.
Ce. <u>OSWEGO</u>	<u>2728</u>			<u>Wakefield</u>
C. <u>SKINNER</u>	<u>2890</u>			
M. <u>Rd FK</u>	<u>2977</u>			Pool
M.	<u>3037</u>			<u>NW Biddle</u>
K.				
Mz.				
Mo.				
V.				
S.				
S.				
A.				
R.				
PE.				
G.				
TD.	<u>3083</u>			

COMPLETE

Date Comm. 8-1-56 AUG 29 1956

10" @ 120/100 WOC AUG 15 '56 7" @

3082/200 AUG 22 '56 CO 3048

18/2902-08 tst 7 Go no/w 90"

Frac Flwd 50 Bo no/w 6 hrs

3/8" ch TP 40# 5.1. AUG 29 '56

Flw 80 Bo no/w 5 hrs + Gas

Flw 25 Bo pd no/w gran

37.7°