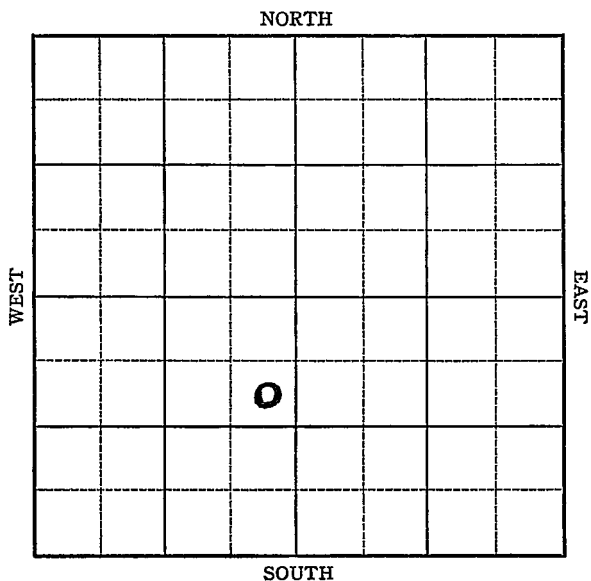


Russell

KANSAS

Section 8 Township 15 Range 13-W **O.W.D.D**Well No. 3 Geo. Rein, Jr.Company Skelly Oil


Sec. 8 Twp. 15 R. 13WWell No. #3 Geo. Rein, Jr. FarmSkelly Oil Company

SE NE SW

NORTH

990 Ft. from N. Line Ft. from S. Line330 Ft. from E. Line Ft. from W. Line

Elev. 1740

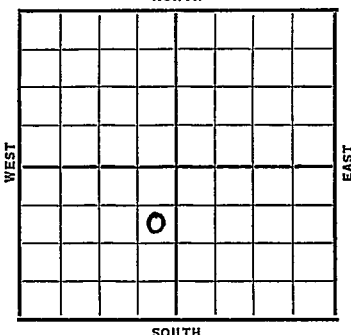

Date	REPORT
1937	
8/25	S.H.
9/3	10" @ 422'. Drlg. 1580'.
9/10	Drlg. 2445'.
9/17	S.O. 2928-41'. Drlg. 3105'.
9/24	Sil. 3169'. 7" @ 3170'.
	T.D. 3172'. 3000' oil 1 hr.
	C.O.
9/29	7" @ 3170'.
	Sil. 3169'.
	T.D. 3172'.
	1000 acid.
	Pot. 2382 bbls.
	COMPLETED
	O.W.D.D
1953	
3/11	SWD well TD 3340
	Arb. 3168 OTD 3172 7" @ 3169 DD Reagan
	3298, Quartzite 3336 TD 3340 4000 A
	Comp. for SWD well
	COMPLETED ABANDONED

FIRST REPORT

KANSAS

Russell

Map No. 73 Sec. 8 Twp. 15 R. 13WWell No. 3-Geo. Rein JrShelley Oil Company**FIRST REPORT**

Contractor

se ne sw**SECTION PLAT**

1990 Ft. from N. Line

_____ Ft. from S. Line

330 Ft. from E. Line

_____ Ft. from W. Line

Location _____

Rig up _____

Drilling and Remarks:

S.H.**RECORD**

Cased _____ in., _____ ft.

Sand _____

Gas _____

Oil _____

Total Depth _____

PRODUCTION

1st 24 hrs. Nat. _____

1st 24 hrs. after shot _____

Gas _____ Cu. Ft.

Dry Hole _____

Abandoned _____

Date

AUG 25 1937

19

H. D. Hatfield

Scout

Russell KANSAS

Map No. _____ Sec. 8 Twp. 15 R. 13WWell No. 3-Geo Rein, Jr.Skelly Oil Company

Contractor _____

COMPLETED

SE NE SW

SECTION PLAT

	0		

990 Ft. from N. Line

_____ Ft. from S. Line

330 Ft. from E. Line

_____ Ft. from W. Line

Location _____

Rig up _____

Drilling and Remarks:

*1000 acid**pot - 2382***RECORD**Cased 1 in. 3170 ft.Sand 511 3169

Gas _____

Oil _____

Total Depth 3172**PRODUCTION**

1st 24 hrs. Nat. _____

1st 24 hrs. after shot _____

Gas _____ Cu. Ft.

Dry Hole _____

Abandoned _____

Date


SEP 21 1937

19

H. D. Hatfield Scout

O. W. D. D

County Russell State Kansas
Sec. 8 (Blk.) 15 (Sur.) 13W Map No.
Operator Skelly Oil
Well No. 3 Farm Rein
Elev. Location SE NE SW

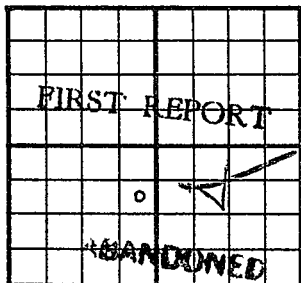

990 Ft. From N Line SW
330 Ft. From E Line Quarter
1st. Report MAR 11 1953
Completion MAR 11 1953
Remarks (OWDD) for SWD

O. W. D. D

Spudding Date

Drlg. Data SWD well TD 3340
Arb. 3168 OTD 3172 7" @ 3169
DD Reagan 3298 Quartzite 3336 TD 3340
4000 A Comp. for SWD well

J. G. McGEHEE