
DX 78-1 Cowley

KANSAS

Section 11 Township 32 Range 4E

Well No. #4 Defore-Roberts

Company Stewart Oil

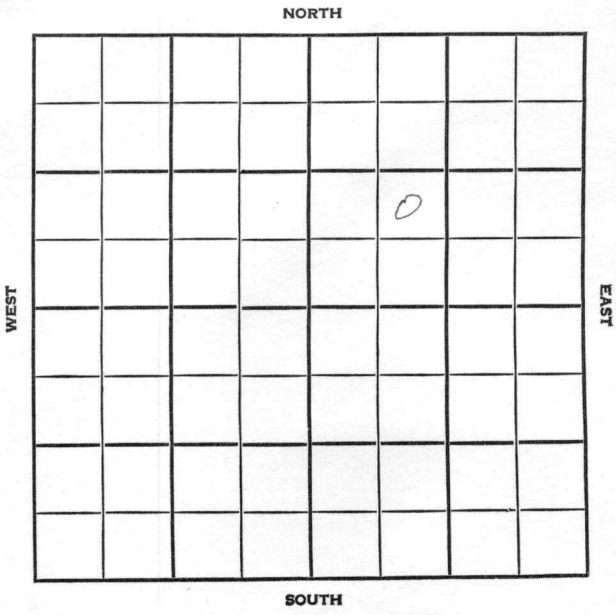

Cowley KANSAS

SEC.	TWP.	R.
1	32	4E

WELL NO.

#4 Defore-Roberts FARM

COMPANY

Stewart Oil

CONTRACTOR

Renfro Tools

Biddle NW


_____ FT. FROM N. LINE

_____ FT. FROM S. LINE

_____ FT. FROM E. LINE

_____ FT. FROM W. LINE

NE SW NE

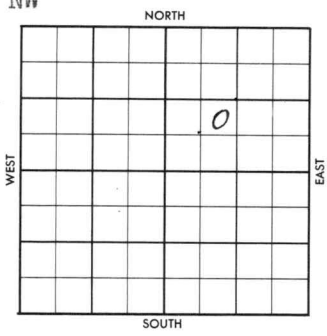

1956	ELEVATION REPORT
8-29	8" @ 117 w/100 Surf. set w/cable tools

FORM 504-5 SUNRAY

FORM 513 SUNRAY

County Cowley Elev.

Sec. 1 Twp. 32 Rge. 4E

Company Stewart Oil

Farm Name Defore-Roberts No. 4

TOPS	DEPTH	LOG	DATUM
Anh.			
T.P.			
H.			
Tr.			
Dg.			
B.L.			
L.			
K.C.			
B.K.C.			
Ce.			
C.			
M.			
M.			
K.			
Mz.			
Mo.			
V.			
S.			
S.			
A			
R.			
P€.			
G.			
T.D.			

Loc. in Sec. NE SW NE

Geol.

Contr. Renfro Tools

Pool Biddle NW



Date Comm.

8" @ 117 w/100, surf ser w/ cable tools

Co. Lse. No. Sec. T. R.

SEP 5 1956

P. G.

FORM 513 SUNRAY

County Cooley Elev. 1240 RB

Sec. 4 Twp. 32 Rge. 4E

Company Stewart Oil

Farm Name Defore-Roberts No. 1

TOPS	DEPTH	LOG	DATUM
Anh.			
Tp. Stall	1895	1895	
H. " sd	1908	1908	
Tr.			
Dg. Lay		2319	
Bl. 1st Lay sd		2328	
L. 2nd " " sd.		2400	
K.C.		2437	
B.K.C.		2609	
Ce. OSW.		2676	
C. Cable sd 2899	2924		
M. Base Cable-		2924	
M.			
K.			
Mz.			
Mc.			
V.			
S.			
S.			
A			
R.			
P€.			
G.			
TD.	2926		

Loc. in Sec. NE SW NE

Geol.

Contr. Renfro Tools

Pool Riddle NW

COMPLETE

OCT 3 '56

Date Comm.

911 w/100, surf ser w/ cable tools

SEP 5 '56 8-24-56 D 2105 SEP 12 '56

5½ @ 2972 / SEP 19 '56 ✓ SEP 26 '56 CO

2948 64/2905-21 $ ¾ BO

ph no/w Frac Flwd 25

Bopd no/wtr. OCT 3 '56

Co. Lse. No. Sec. T. R.