

Cowley


KANSAS
4E

SECTION 1 TOWNSHIP 32 RANGE 4E

WELL NO. #5 Defore-Roberts

COMPANY Stewart Oil Co.

NORTH

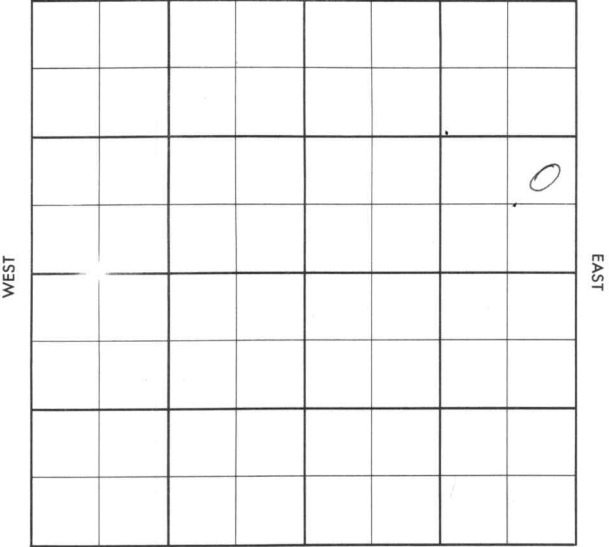

SOUTH

County Cowley Elev. 1241
 Sec. 1 Twp. 32 Rge. 4E
 Company Stewart Oil Co.
 Farm Name DeFore-Roberts No. 5

TOPS	DEPTH	LOG	DATUM
Anh.			
Tp.			
H. <u>stall</u>		<u>1887</u>	
Tr.			
Dg. <u>ldy</u>		<u>2317</u>	
Bl.			
L.			
K.C.		<u>2435</u>	
B.K.C.		<u>2581</u>	
Ce. <u>Marm</u>		<u>2674</u>	
G. <u>osw</u>		<u>2727</u>	
M. <u>ce</u>		<u>2796</u>	
M. <u>catless</u>		<u>2910</u>	
K.			
Mz.			
Ma.			
V.			
S.			
S.			
A.			
R.			
PE.			
G.			
T.D.	<u>3003</u>		

Loc. in Sec. NE SE NE

Geol. _____

Contr. _____

Wakefield
Tools

Pool _____

Biddle NW

COMPLETE

JAN 16 '57

Date Comm. DEC 26 '55 ✓ JAN 2 '57

Location 12-26-56 85/8 120/60 5 1/2
3000/175 JAN 9 '57 CO 2930 64/
2912-20 JAN 16 '57 β 1/3 Boph
10 hrs 100 gal Acid FU 200' oil
8 hrs Frac 2 1/2 x 2 1/2 Flw 125
Bo no/w 5 1/2 hrs 24/64" T69 ch
Flw 25 Boph no/w tr.

Co.
Use.
No.
Sec.
T.
R.