


Cowley

KANSAS

SECTION #1 TOWNSHIP 32 RANGE 4E

WELL NO. #6 Long "A"

COMPANY Stewart Oil Co.

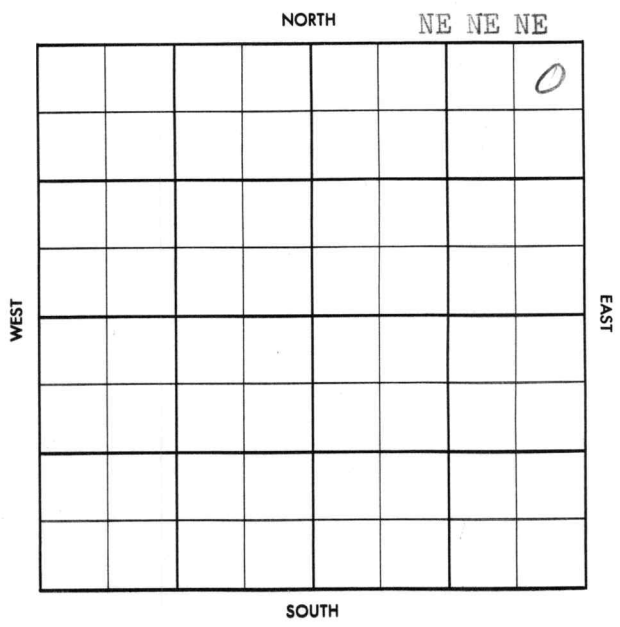

County Cowley Elev. _____
 Sec. 1 Twp. 32 Rge. 4E
 Company Stewart Oil Co.
 Farm Name Long "A" No. 6

| TOPS | DEPTH | LOG | DATUM | Loc. in Sec. |
|--------|-------|-----|-------|--------------|
| Anb. | | | | NE NE NE |
| Tr. | | | | (twin) |
| Dg. | | | | |
| Bl. | | | | |
| L. | | | | Geol. _____ |
| K.C. | | | | Contr. _____ |
| B.K.C. | | | | White & Ell |
| Ce. | | | | |
| C. | | | | Pool |
| M. | | | | Biddle NW |
| M. | | | | |
| K. | | | | |
| Mz. | | | | |
| Me. | | | | |
| V. | | | | |
| S. | | | | |
| S. | | | | |
| A. | | | | FIRST REPORT |
| R. | | | | |
| Pe. | | | | JUL 3 1957 |
| G. | | | | |
| T.D. | | | | |

Date Comm. _____
 Location _____

29

Co.
L.S.
No.
Sec.
T.
R.

County Cowley Elev. 1249
 Sec. 1 Twp. 32 Rge. 4E
 Company Stewart Oil Co.
 Farm Name Long "A" No. 6

| TOPS | DEPTH | LOG | DATUM | Loc. in Sec. |
|------------------|-------------|-----|-------|--------------|
| Anh. | | | | NE NE NE |
| Tp. | | | | (twin) |
| H. | | | | |
| Tr. | | | | |
| Dg. <u>stain</u> | <u>1876</u> | | | |
| Bl. <u>lay</u> | <u>2304</u> | | | |
| L. <u>"sd"</u> | <u>2311</u> | | | |
| K.C. | | | | Geol. |
| B.K.C. | | | | Contr. |
| Ce. | | | | White & Ell |
| C. | | | | |
| M. | | | | Pool |
| K. | | | | Biddle NW |
| Mz. | | | | |
| Ma. | | | | |
| V. | | | | |
| S. | | | | |
| S. | | | | |
| A. | | | | |
| R. | | | | |
| Pe. | | | | |
| G. | | | | |
| T.D. | <u>2370</u> | | | |

AUG 14 57

COMPLETE

Date Comm. _____
 Location JUL 10 57 7-6-57 85/8 201
D 1640 JUL 17 57 DST 2305-23
or 140" Flwd oil in 2 hrs
BHP 715A DST 2327-33 or
90" rec 45' GCM 270 /20"
5 1/2 2369 WOC JUL 24 57 JUL 31 57 CO
2347 16/2315-19 \$ 4 Boph
POP AUG 8 57 W.O. Tot. AUG 14 57 X Ph.P.
80% Bopd + 60% wt. g. saw 40"
lay sd PF. 2315-19 RTP 2370 PBD 2347