

DX 78-1


Cowley

KANSAS

Section 1 Township 32 Range 4E

Well No. #2 Morris

Company O. A. Sutton

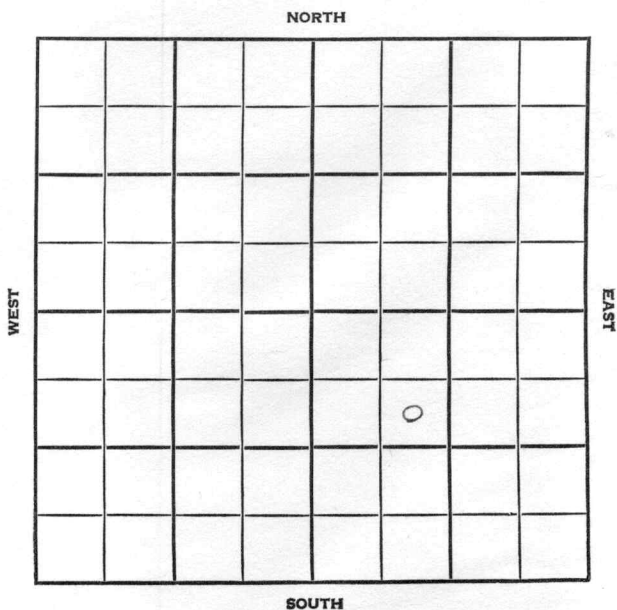

SEC.	TWP.	R.
1	32	4E

WELL NO.

#2 Morris

FARM

COMPANY

O. A. Sutton

CONTRACTOR

Renfro


N. W. Biddle

FT. FROM N. LINE

FT. FROM S. LINE

FT. FROM E. LINE

FT. FROM W. LINE

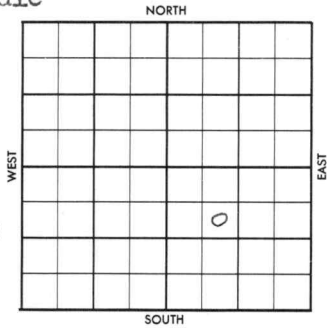

SE NW SE

1956	ELEVATION	REPORT
6-27	1212'	M I R

7-25

Comm. 6-26-56
 8 5/8" @ 120 w/100
 DST 2295-2312 op 1 hr. rec. 135' mud,
 † 360' SW, BHP 690/20".
 5 1/2" @ 2950
 DST 2882-96 op 1 hr. gas in 12 min.,
 rec. 160' gssy oil † 60' HOCM † 90'
 OCM † 30' wtr., 1125/20".
 CO 2931- 32/2884-92
 FU 20 bbls. oil in 16 hrs.
~~###~~ S/ 8 3/4 BO in 4 hrs.
 S/ 52 BO † 10 Bbls. acid wtr., 8 hrs.
 P/ 25 BOPD, no/wtr.
 Stall. 1870'; Lay. 2283';
 Log tops:
 Stall. 1869'; Lay. 2283'; KC 2407';
 Osw. 2646'; Cattle Sd. 2872';
 Bartl. 2962';
 TD 2980'

COMPLETED

County Cowley Elev. 4E
 Sec. 1 Twp. 32 Rge. 4E
 Company O. A. Sutton
 Farm Name Morris No. 2

TOPS	DEPTH	LOG	DATUM	Loc. in Sec.
Anh.				SE NW SE
Tp.				
H.				
Tr.				
Dg.				
B.L.				
L.				Geol.
K.C.				Contr.
B.K.C.				<u>Renfro</u>
Ce.				Pool
C.				<u>NW Biddle</u>
M.				
M.				
K.				
Mz.				
Mq.				
V.				
S.				
S.				
A.				
R.				
Pe.				
G.				
T.D.				

FIRST REPORT
 JUN 27 '56

Date Comm. M I R

[Handwritten signature and scribbles]

29R

Co.
Lse.
No.
Sec.
T.
R.

Co.

County Covley Elev. 1212
 Sec. 1 Twp. 32 Rge. 1E
 Company O. A. Sutton
 Farm Name Morris No. 2

	TOPS	DEPTH	LOG	DATUM	Loc. in Sec.
Anh.	<u>still</u>	<u>1870</u>	<u>1869</u>		<u>SE NW SE</u>
Tp.	<u>lay</u>	<u>2283</u>	<u>2283</u>		
H.					
Tr.					
Dg.					
Bl.					
L.					
K.C.			<u>2407</u>		Geol.
B.K.	<u>OSW</u>		<u>2646</u>		Contr.
Ge.	<u>Cattle sd</u>		<u>2872</u>		<u>Renfro</u>
C.	<u>Bartl</u>		<u>2962</u>		
M.					
M.					Pool
K.					<u>NW Biddle</u>
Mz.					
Mo.					
V.					<div style="border: 1px solid black; padding: 5px; text-align: center;"> <p>COMPLETE</p> <p>JUL 25 1956</p> </div>
S.					
S.					
A.					
R.					
PE.					
G.					
TD.		<u>2980</u>			

Loc.

No.

Sec.

T.

R.

Date Comm. MIP JUL 3 '56 6-26-56 85/8
120/100 DST 2295-2312 1hr
see 135' Md + 360' SW BHP
690/20 JUL 11 '56 5 1/2 @ 2950 JUL 18 '56
DST 2882-96 1hr gin 12"
see 160' gssy oil + 60' HOCM
+ 90' OCM + 30' wt 1125/20"
CO 2931- 32/2884-92 G550
FU 20 Barrells oil in 16 hrs

\$ 8³/₄ Bo in 4 hrs $\frac{1}{4}$
\$ 52 Bo + 10 B acid wt
8 hrs JUL 25 '56 P. 25 Bopd
no/wt