

Cowley

KANSAS

1

32

4E

SECTION _____ TOWNSHIP _____ RANGE _____


#6 Morris

WELL NO. _____

O.A. Sutton

COMPANY _____

NORTH

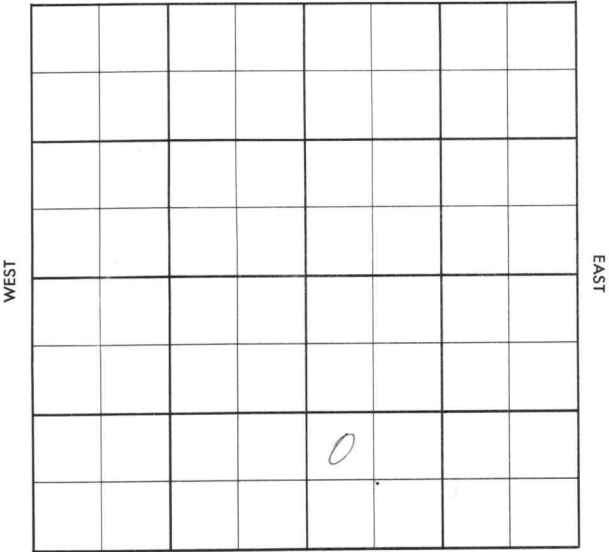

SOUTH

County Covley Elev. _____
 Sec. 1 Twp. 32 Rge. 4E
 Company O. A. Sutton
 Farm Name Morris No. 6

TOPS	DEPTH	LOG	DATUM	Loc. in Sec.
Anh.				NW SW SE
TP.				
H.				
Tr.				
Dg.				
BL.				
L.				Geol. _____
K.C.				Contr. _____
B.K.C.				Renfro Drlg.
Ce.				Tools
C.				Pool
M.				Biddle NW
M.				
K.				
Mz.				
Me.				
V.				
S.				
S.				
A.				FIRST REPORT
R.				
PE.				SEP 19 56
G.				0
T.D.				

Date Comm. 9-15-56
8" @ 155 w/125 SEP 26 '56

8281 5 5 1956

209

R.G.

Co.
Lsc.
No.
Sec.
T.
R.

County Cowley Elev. 1218 DF
 Sec. 1 Temp. 32 Rgs. 4E
 Company O. A. Sutton
 Farm Name Morris No. 6

TOPS	DEPTH	LOG	DATUM
Anh.			
Tp. <u>stall</u>		<u>1877</u>	
H. <u>Lay</u>		<u>2299</u>	<u>1071</u>
Tr.			
Dg.			
Bl.			
L.			
K.C.		<u>2430</u>	
B.M. <u>OSW</u>		<u>2676-2789</u>	
Ce. <u>CaHle sd</u>		<u>2888</u>	
C.			
M.			
M.			
K.			
Mz.			
Ma			
V.			
S.			
S.			
A.			
R.			
PE.			
G.			
TD.	<u>2940</u>		

Loc. in Sec. NW SW SE
 Geol. _____
 Contr. Renfro Drlg.
Tools
 Pool Biddle NW

COMPLETE
 OCT 17 '56

Date Comm. 9-15-56
8" @ 155 w/125 'SEP 20 '56 CR 2891-2926
Full rec. DST 2909-38 w/1 hr
rec 30' Md + 120' MSW BHP
990 5 1/2 @ 2939 MICT OCT 3 '56
48/2891-2903 OCT 10 '56 RePPF 2898
- 2904 Frac FU 8 Bo in
12 hrs @ 3/4 Boph + TR oil
TR & R OCT 17 '56 P. 35 Bopd +
1 Bwpd.

Co.
 L. Sec.
 No.
 Sec.
 T.
 R.