


Section 1 Township 32 Range 4E
Well No. #1 Blanche R. Morris
Company The Texas Company

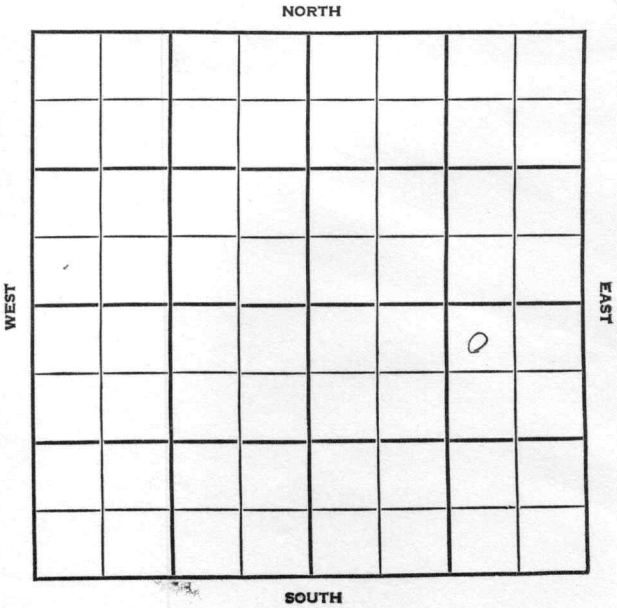

Cowley

SEC.	TWP.	R.
1	32	1E

WELL NO. _____

1 Blanche R. Morris FARM

COMPANY _____

The Texas Company

CONTRACTOR _____


Wakefield
Biddle NW

_____ FT. FROM N. LINE

_____ FT. FROM S. LINE

_____ FT. FROM E. LINE

_____ FT. FROM W. LINE

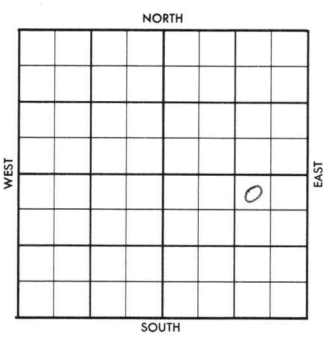

NW NE SE

	ELEVATION	REPORT
1956	1240'	

6-20 Comm. 6-14-56
10" @120 w/125,
rng DST #1,
Drlg. 2339

7-3 DST 2320-39 op 2 hrs., rec. 1000'
SW, BHP 720/45"
7" @ 3092 w/100
CO 3058, 18/ 2908-14,
B/ 8 B0 in 2 hrs.,
P/ 45 B0, no/wtr., 24 hrs.
Grav. 40°
Log Tops:
Cat. grove 2325', Li. 2437',
BKC 2577', Ce. 2786', Skin sd. 2907',
M. 3040'.
TD 3095'.

COMPLETED

County Cowley Elev. _____
 Sec. 1 Twp. 32 Rge. 4E
 Company The Texas Co.
 Farm Name Blanche R. Morris No. 1

TOPS	DEPTH	LOG	DATUM
Anh.			
Tp.			
H.			
Tr.			
Dg.			
Bl.			
L.			
K.C.			
B.K.C.			
Ce.			
C.			
M.			
M.			
K.			
Mz.			
Mo.			
V.			
S.			
S.			
A.			
R.			
Pe.			
G.			
T.D.			

Loc. in Sec. _____
NW NE SE
 Geol. _____
 Contr. _____
Wakefield
 Pool _____
Biddle NW



Date Comm. 6/14/56 JUN 20 '56
10" 120 w/125, rng DST #1, D 2339

[Handwritten signature]

JUN 25 1956
[Handwritten signature]

Co.
Lse.
No.
Sec.
T.
R.

29

County Cowley Elev. 1240
 Sec. 1 Twp. 32 Rge. 1E
 Company The Texas Co.
 Farm Name Blanche R. Morris No. 1

Co.
Lse.
No.
Sec.
T.
R.

TOPS	DEPTH	LOG	DATUM	Loc. in Sec.
Anh.				
Sp. <u>Cot Grove</u>		<u>2325</u>		<u>NW NE SE</u>
H.				
Tr.				
Dg.				
Bl.				
L.				
K.C. <u>L1</u>		<u>2437</u>		Geol.
B.K.C.		<u>2577</u>		Contr.
Ce.		<u>2786</u>		
e. <u>SKIN sd</u>		<u>2907</u>		<u>Wakefield</u>
M.		<u>3040</u>		Pool
M.				<u>Biddle NW</u>
K.				
Mz.				
Me.				
V.				
S.				
S.				
A.				
R.				
PE.				
G.				
T.D.	<u>3095</u>			



Date Comm. 6/11/56 JUL 3 1956
 10" 120 w/125, rmg DST #1, D 2339 JUN 27 '56

DST 2320-39 2 hrs rec 1000'
SW BHP 720/45" 7" @ 3092
1100 JUL 3 '56 ca 3058 18/2908-14
B 8 B0 in 2 hrs P. 45 B0
notw 24 hrs grav 40°