

Map No.----- Sec. 11 Twp. 27 R. 3

Well No. 2 Knutson Farm

Wm. & Hale Company

NORTH

W

WEST

EAST

COMPLETED

SOUTH

Location_____

Drilling Remarks:

Rig Up-----

Drilling Remarks:

RECORD

Cased_____ in._____ft.

Sand -----

Gas: _____

Oil _____

Total Depth_____

PRODUCTION

1st 24 hrs. Nat.-----

1st 24 hrs. after shot-----


Gas_____cu. ft

Dry Hole-----

Abandoned -----

Map No. _____ Sec. 11 Twp. 27 R. 5
 Well No. 3 Thompson Farm
Kroy & Hall Company

NORTH

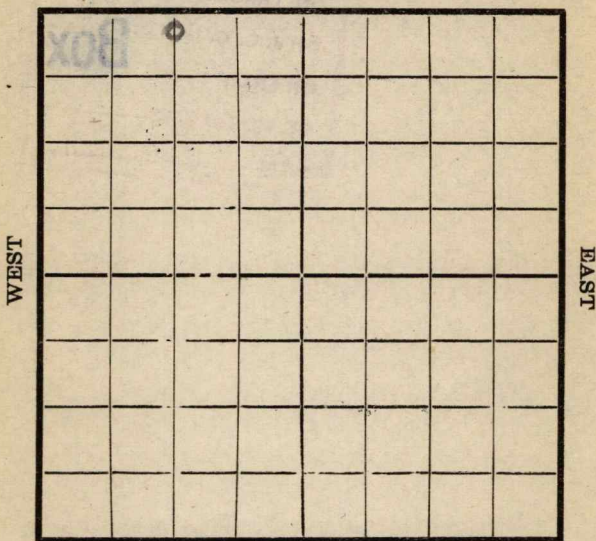

SOUTH

Location _____
 Rig Up ☒ _____
 Drilling and remarks _____

RECORD

Cased _____ in. _____ Ft.
 Sand _____
 Gas _____
 Oil _____
 Total Depth _____

FIRST REPORT

PRODUCTION

1st 24 hrs. Nat. _____
 1st 24 hrs. after shot _____
 Gas _____ Cu. Ft.
 Dry Hole _____
 Abandoned _____


Date

9/5, 1917 Cordiff Scout

Map No. _____ Sec. 11 Twp. 27 R. 5
 Well No. 3 _____ Farm _____
Knox & Hall _____ Company

NORTH

WEST

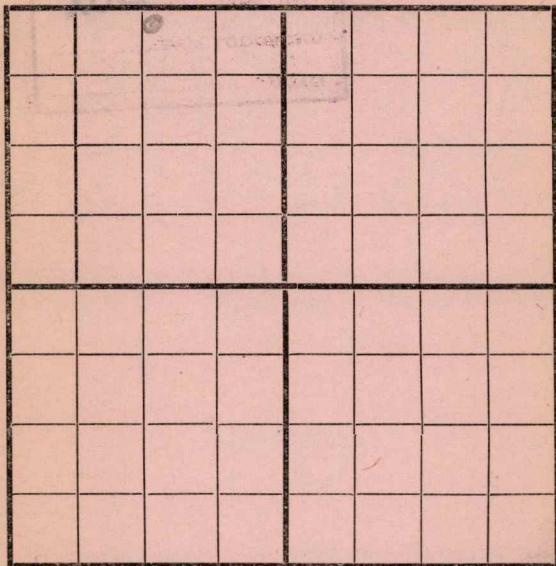

EAST

SOUTH

Location _____
 Rig Up ☒ _____
 Drilling and remarks _____

FIRST REPORT

RECORD

Cased _____ in. _____ Ft.
 Sand _____
 Gas _____
 Oil _____
 Total Depth _____

PRODUCTION

1st 24 hrs. Nat. _____
 1st 24 hrs. after shot _____
 Gas _____ Cu. Ft.
 Dry Hole _____
 Abandoned _____

Date


9/12, 1917 Cardiff Scout

Form No. 10-1-1900 Reams 111
Map No. _____ Sec. 11 Twp. 27 R. 5

Well No. 3 Huntson Farm

Horseshill Company

NORTH

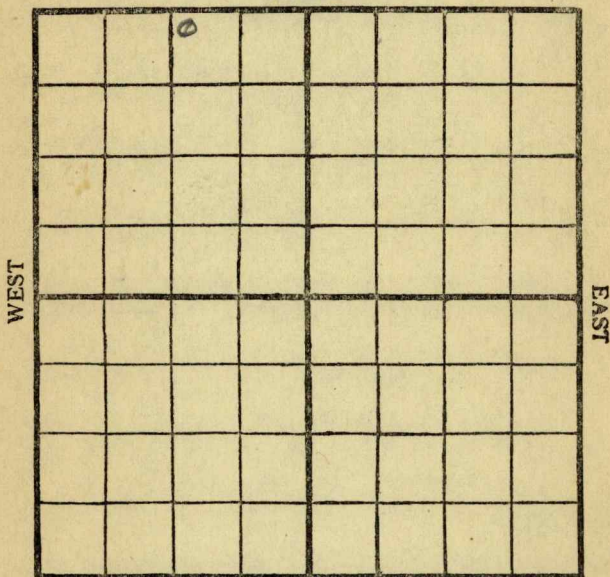

SOUTH

Location _____

Rig Up _____

Drilling and remarks

1300

RECORD

Cased _____ in. _____ Ft.

Sand _____

Gas _____

Oil _____

Total Depth _____

PRODUCTION

1st 24 hrs. Nat. _____

1st 24 hrs. after shot _____

Gas _____ Cu. Ft.

Dry Hole _____

Abandoned _____

Date

10/2, 1917, C. C. C. Scout


Map No. _____ Sec. 11 Twp. 27 R. 5

Well No. 3 Huntman Farm

Knock & Hale Company

NORTH

WEST

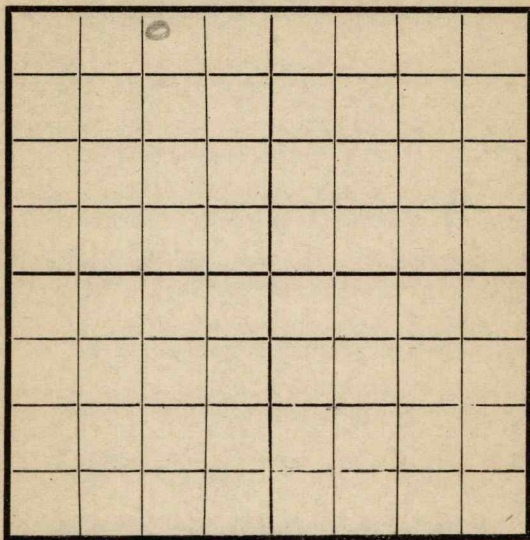

EAST

SOUTH

Location _____

Rig Up _____

Drilling and remarks

RECORD

Cased _____ in. _____ Ft.

Sand _____

Gas _____

Oil _____

Total Depth _____

PRODUCTION

1st 24 hrs. Nat. _____

1st 24 hrs. after shot _____

Gas _____ Cu. Ft.

Dry Hole _____

Abandoned _____

Date


10/9, 1917 Candy Scout

Map No. _____ Sec. 11 Twp. 27 R. 5Well No. 3 Kuntson Farm
Kings & Hall Company

NORTH

WEST

EAST

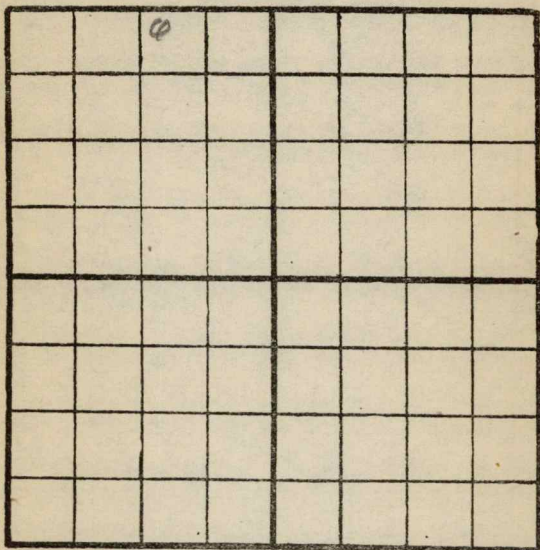

SOUTH

Location _____

Rig up _____

Drilling and remarks:

Shut Down
for water
1820

RECORD

Cased _____ in. _____ Ft.

Sand _____

Gas _____

Oil _____

Total Depth _____

PRODUCTION

1st. 24 hrs. Nat. _____

1st. 24 hrs. after shot _____

Gas _____ Cu. Ft.

Dry Hole _____

Abandoned _____


Date

10/17 1917 Carbiff Scout

Map No. _____ Sec. 11 Twp. 27 R. 5Well No. 3 Huntman Farm
Knapp & Hale Company

NORTH

WEST

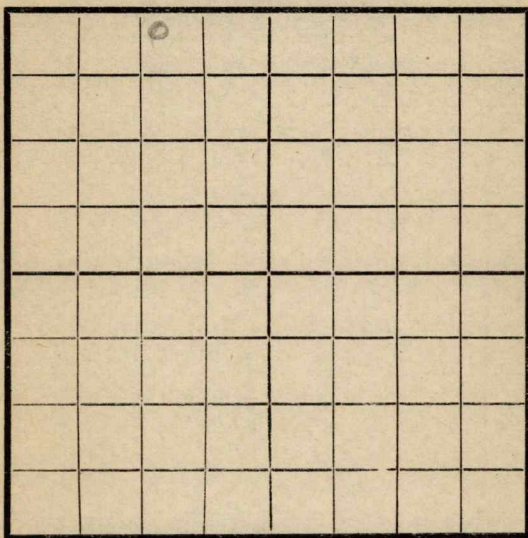

EAST

SOUTH

RECORD

Location _____

Cased _____ in. _____ Ft.

Rig Up _____

Sand _____

Drilling and remarks

Gas _____

Oil _____

Total Depth _____

PRODUCTION

1st 24 hrs. Nat. _____

1st 24 hrs. after shot _____

Gas _____ Cu. Ft.

Dry Hole _____

Abandoned _____


Date

10/24, 1911 J. Carver Scout

Map No. _____ Sec. 11 Twp. 27 R. 5Well No. 3 Kuntam Farm
Conner Company

NORTH

WEST

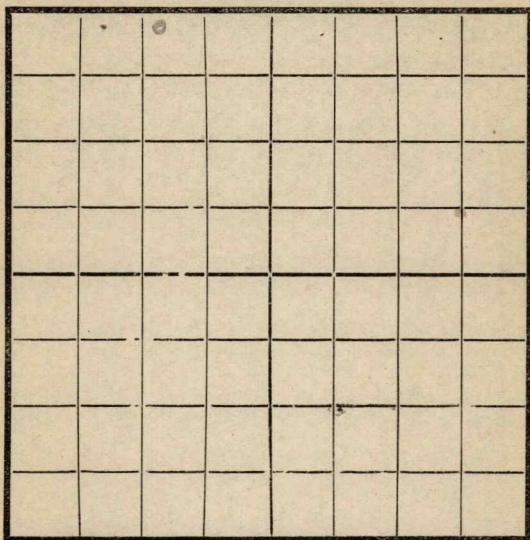

EAST

SOUTH

Location _____

Rig Up _____

Drilling and remarks

22 1820

RECORD

Cased _____ in. _____ Ft.

Sand _____

Gas _____

Oil _____

Total Depth _____

PRODUCTION

1st 24 hrs. Nat. _____

1st 24 hrs. after shot _____

Gas _____ Cu. Ft.

Dry Hole _____

Abandoned _____


Date

10/31, 1917 Conner Scout

Map No. _____ Sec. 11 Twp. 27 R. 5Well No. 3 Kuntson Farm
Eureka Oil Company

NORTH

WEST

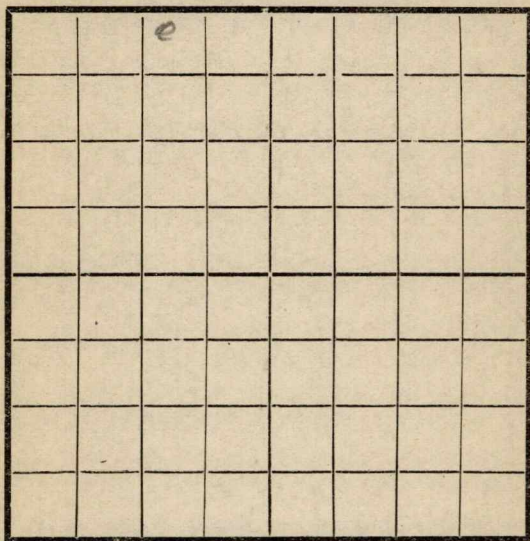

EAST

SOUTH

Location _____

Rig Up _____

Drilling and remarks

fishing C.C.
1820

RECORD

Cased _____ in. _____ Ft.

Sand _____

Gas _____

Oil _____

Total Depth _____

PRODUCTION

1st 24 hrs. Nat. _____

1st 24 hrs. after shot _____

Gas _____ Cu. Ft.

Dry Hole _____

Abandoned _____

Date


11-7, 1917 *Condy* Scout

Map No. _____ Sec. 11 Twp. 27 R. 5

Well No. 34 Farm _____
Eureka Oil Company

NORTH

WEST

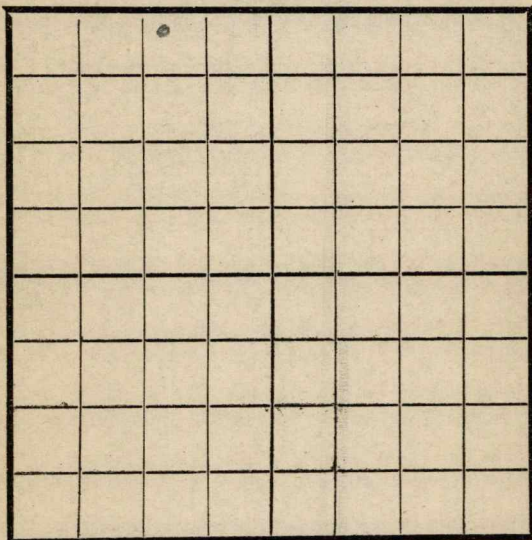

EAST

SOUTH

Location _____

Rig Up _____

Drilling and remarks

*Collapsed
 casing
 1820*

RECORD

Cased _____ in. _____ Ft.

Sand _____

Gas _____

Oil _____

Total Depth _____

PRODUCTION

1st 24 hrs. Nat. _____

1st 24 hrs. after shot _____

Gas _____ Cu. Ft.

Dry Hole _____

Abandoned _____


Date

11-14, 1917 *Conroy* Scout

Map No. 111 Sec. 11 Twp. 27 R. 5Well No. 3 Kuntz Farm
European Oil Company

NORTH

WEST

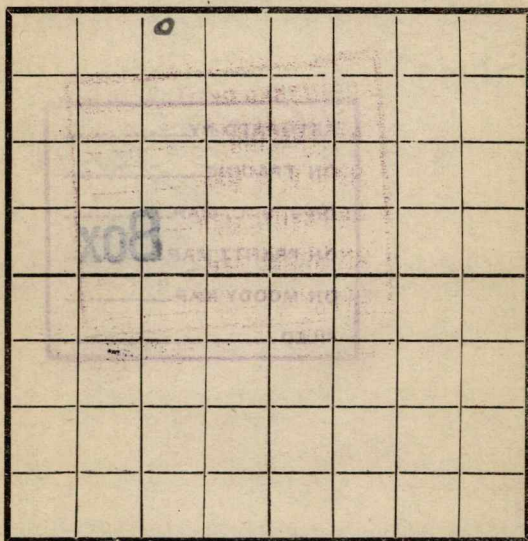

EAST

SOUTH

RECORD

Location -----

Cased ----- in. ----- Ft.

Rig Up -----

Sand -----

Drilling and remarks

Gas -----

Oil -----

Total Depth -----

PRODUCTION

1st 24 hrs. Nat. -----

1st 24 hrs. after shot -----

Gas ----- Cu. Ft.

Dry Hole -----

Abandoned -----

Date

11/21, 1917 Cordery Scout


Map No. _____ Sec. 11 Twp. 27 R. 5

Well No. 3 Huntson Farm

Eureka Company

NORTH

WEST

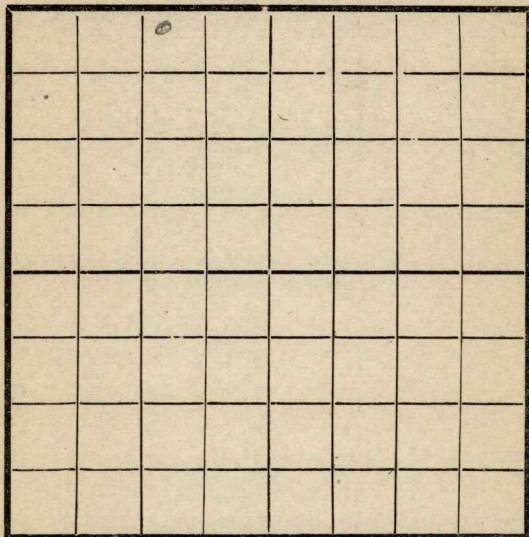

EAST

SOUTH

Location _____

Rig Up ☒ _____

Drilling and remarks _____

RECORD

Cased _____ in. _____ Ft.

Sand _____

Gas _____

Oil _____

Total Depth _____

PRODUCTION

1st 24 hrs. Nat. _____

1st 24 hrs. after shot _____

Gas _____ Cu. Ft.

Dry Hole _____

Abandoned _____


Date

11/28, 1917 Carby Scout

Map No. _____ Sec. 11 Twp. 27 R. 5
 Well No. 3 Knutson Farm _____
Eureka Company _____

NORTH

WEST

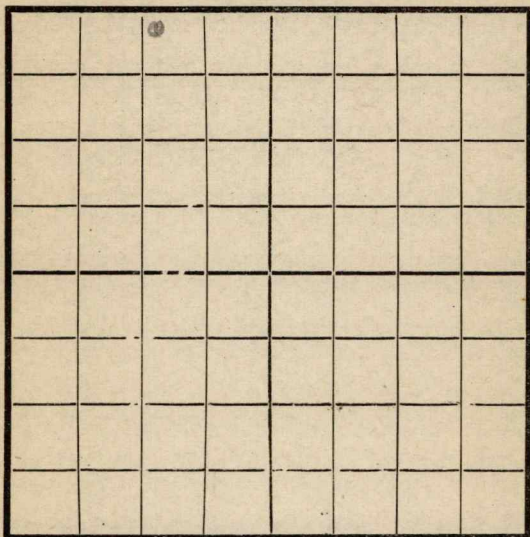

EAST

SOUTH

Location _____
 Rig Up _____
 Drilling and remarks _____

RECORD

Cased _____ in. _____ Ft.
 Sand _____
 Gas _____
 Oil _____
 Total Depth _____

PRODUCTION

1st 24 hrs. Nat. _____
 1st 24 hrs. after shot _____
 Gas _____ Cu. Ft.
 Dry Hole _____
 Abandoned _____


Date

12/5, 1917 Condy Scout

Map No. _____ Sec. 11 Twp. 27 R. 5Well No. 3 Huntson Farm
Emery Company

NORTH

WEST

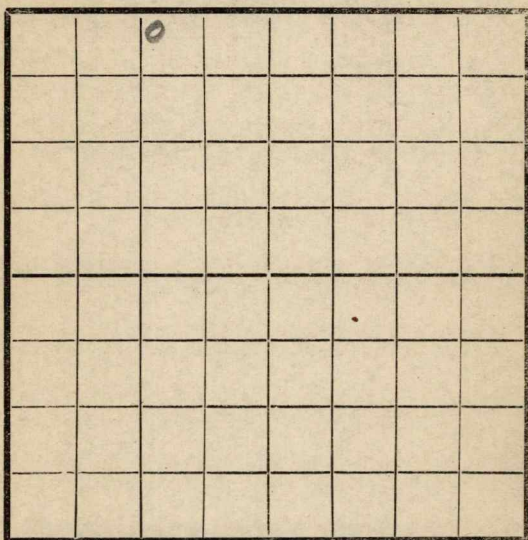

EAST

SOUTH

Location _____

Rig Up _____

Drilling and remarks

Spudding

RECORD

Cased _____ in. _____ Ft.

Sand _____

Gas _____

Oil _____

Total Depth _____

PRODUCTION

1st 24 hrs. Nat. _____

1st 24 hrs. after shot _____

Gas _____ Cu. Ft.

Dry Hole _____

Abandoned _____


Date

12/52 191 7 Conley Scout

Map No. _____ Sec. 11 Twp. 27 R. 5Well No. 3 Kuntson Farm _____
Encke Company _____

NORTH

WEST

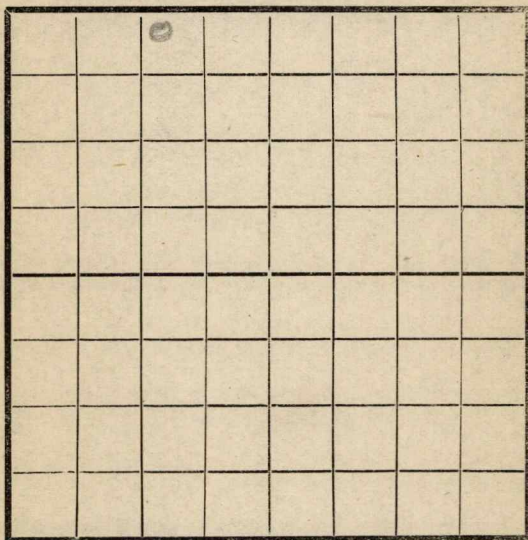

EAST

SOUTH

Location _____

Rig Up _____

Drilling and remarks

LD 100

RECORD

Cased _____ in. _____ Ft.

Sand _____

Gas _____

Oil _____

Total Depth _____

PRODUCTION

1st 24 hrs. Nat. _____

1st 24 hrs. after shot _____

Gas _____ Cu. Ft.

Dry Hole _____

Abandoned _____


Date

12/19 1917 Carney Scout

Map No. _____ Sec. 11 Twp. 27 R. 5Well No. 3 Knutson Farm
Emerson Oil Company

NORTH

WEST

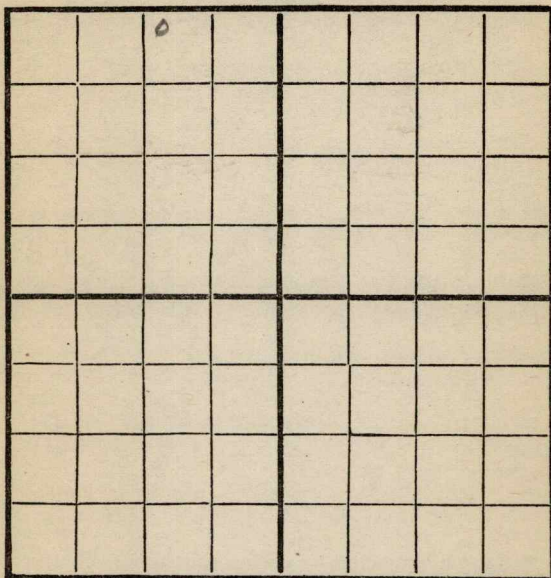

EAST

SOUTH

Location _____

Rig Up _____

Drilling and remarks

250 SD

RECORD

Cased _____ in. _____ Ft.

Sand _____

Gas _____

Oil _____

Total Depth _____

PRODUCTION

1st 24 hrs. Nat. _____

1st 24 hrs. after shot _____

Gas _____ Cu. Ft.

Dry Hole _____

Abandoned _____

Date


1/2, 1918, C. Carney Scout

Map No. _____ Sec. 11 Twp. 27 R. 5

Well No. 3 Knutson Farm
Eureka Oil Company

NORTH

WEST

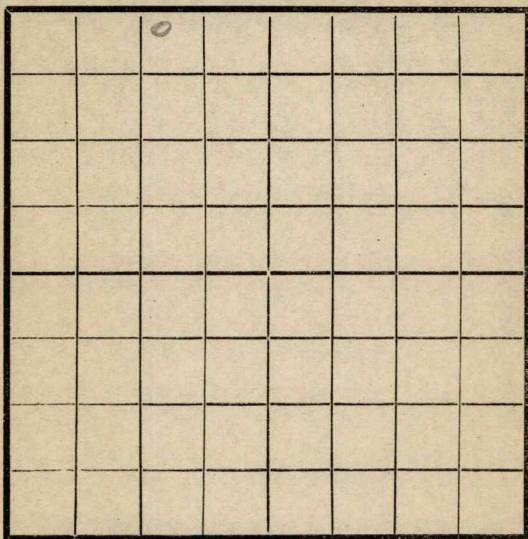

EAST

SOUTH

Location _____

Rig Up _____

Drilling and remarks

22 250

RECORD

Cased _____ in. _____ Ft.

Sand _____

Gas _____

Oil _____

Total Depth _____

PRODUCTION

1st 24 hrs. Nat. _____

1st 24 hrs. after shot _____

Gas _____ Cu. Ft.

Dry Hole _____

Abandoned _____


Date

1/9, 1911 S. Condy Scout

Map No. _____ Sec. 11 Twp. 27 R. 5Well No. 3 Kmetson Farm _____
Emeka Oil Company

NORTH

WEST

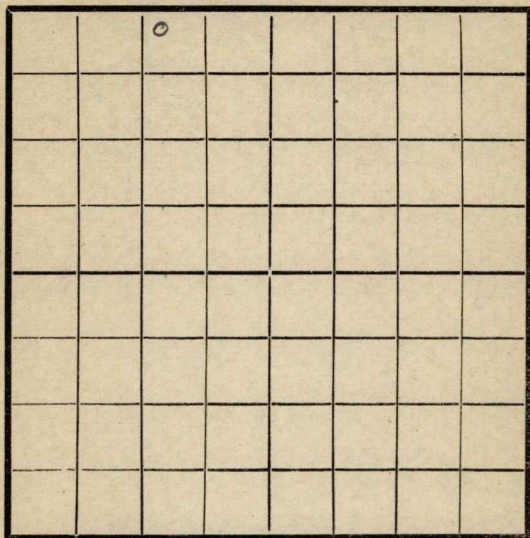

EAST

SOUTH

Location _____

Rig Up _____

Drilling and remarks

SD 250

RECORD

Cased _____ in _____ Ft.

Sand _____

Gas _____

Oil _____

Total Depth _____

PRODUCTION

1st 24 hrs. Nat. _____

1st 24 hrs. after shot _____

Gas _____ Cu. Ft.

Dry Hole _____

Abandoned _____


Date

1/16, 1918 Cordery Scout

Map No. _____ Sec. 11 Twp. 27 R. 5Well No. 3 Huntson FarmEncke Company

NORTH

WEST

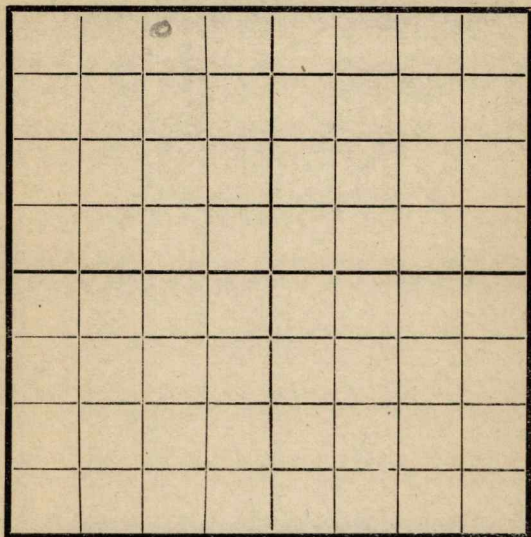

EAST

SOUTH

RECORD

Location _____

Cased _____ in. _____ Ft.

Rig Up _____

Sand _____

Drilling and remarks

Gas _____

Oil _____

Total Depth _____

PRODUCTION

1st 24 hrs. Nat. _____

1st 24 hrs. after shot _____

Gas _____ Cu. Ft.

Dry Hole _____

Abandoned _____


Date

1/23, 1918 Conroy Scout

Map No. R 11 Sec. 11 Twp. 27 R. 5Well No. 3 Kuntom Farm
Eureka Oil Company

NORTH

WEST

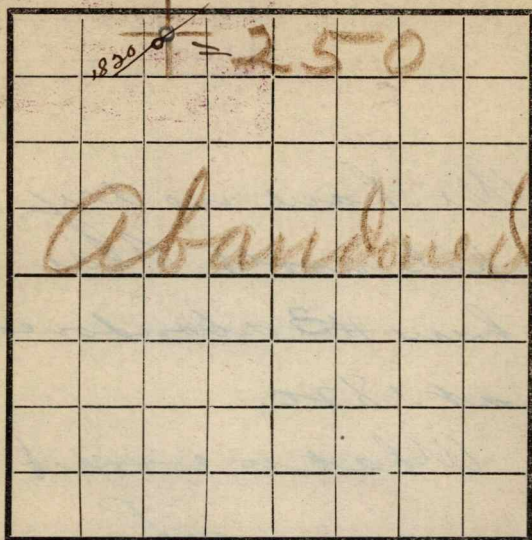

EAST

SOUTH

Location -----

Rig Up -----

Drilling and remarks

Abandoned
at 250' on
account
of dry hole
with

RECORD

Cased ----- in. ----- Ft.

Sand -----

Gas -----

Oil -----

Total Depth -----

PRODUCTION

1st 24 hrs. Nat. -----

1st 24 hrs. after shot -----

Gas ----- Cu. Ft.

Dry Hole -----

Abandoned -----

Date

2/13, 1918 Conley Scout

RETURNED BY

ON TRACING

ON J. C. C. MAP

ON FRANTZ MAP

ON MOODY MAP

FILED

Box

We have no dry
hole north. Also
have #3 abandoned
at 1820'.

What is correct

3/3/18 =

Texas Co # Smack
right north of here is
only a very light well.
In fact they will probably
plug it. So The Eureka Oil
Co. decided to abandon
offsetting it. They
originally had a bad hole
and skidded the rig abandoning
the old one at 1820' = This one
they abandon at 250'
L. C. C.