


Section 1 Township 32 Range 4E

Well No. #1 Roberts

Company O.A. Sutton & Sunray Mid-Continent

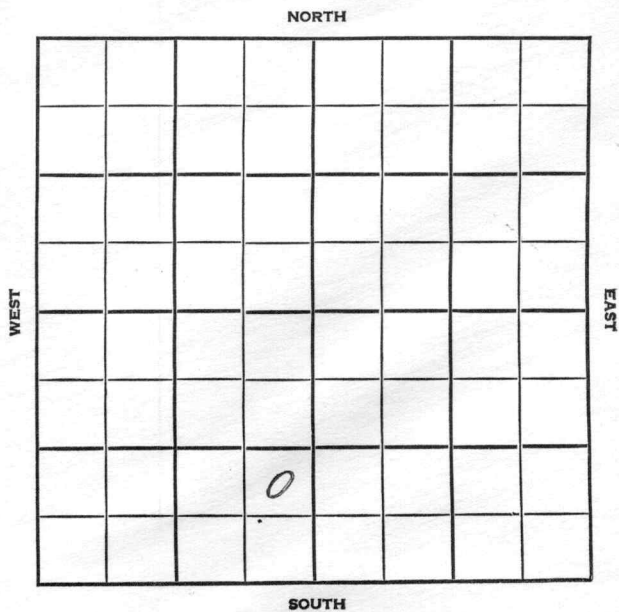

HOT FILE

Cowley

KANSAS

SEC.	TWP.	R.
1	32 S	4 E

WELL NO. # 1 **Roberts**
~~DeFore~~ FARM

COMPANY O. A. Sutton (DEVELOPMENT-OB0C)

CONTRACTOR & SDX
 Renfro Tools


Biddle Field Area

_____ FT. FROM N. LINE

_____ FT. FROM S. LINE

_____ FT. FROM E. LINE

_____ FT. FROM W. LINE

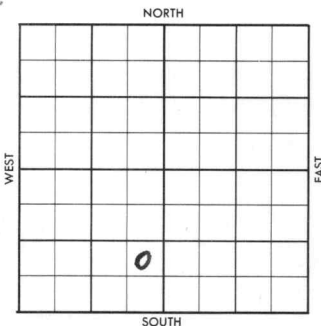

NE SE SW

no contract

1956	ELEVATION 1236'	REPORT (WH6-EX37)
------	-----------------	-------------------

2900' Cattleman Test

- 10/30 Spudded 10-27-56 8"@151 w/130
Drlg. 1380' Stall Li 1903 (DR#212)
- 10/31 Drlg. 2006' Stall. Sd 1925' (FR Tkt)
- 11/1 Drlg. 2523'
- 11/2 TD 2523' NR
- 11/5 Drlg. 3037'
- 11/6 TD 3037'. Dry & Abd. (DR#217)
- 11/16 Comm. 10-28-56
Comp. 11-2-56
TD 3037' P & A (

ABANDONED

118

County Cowley Elev. 1236
 Sec. 1 Twp. 32 Rge. 4E
 Company O. A. Sutton & Sunray Mid-Continent
 Farm Name Roberts No. 1

TOPS	DEPTH	LOG	DATUM
Anh.			
TP.			
H.			
Tr.			
Dg.			
B.L.			
L.			
K.C.			
B.K.C.			
Ce.			
C.			
M.			
M.			
K.			
Mz.			
Me.			
V.			
S.			
S.			
A.			
R.			
PE.			
G.			
T.D.			

Loc. in Sec. NE SE SW
 Geol. _____
 Contr. _____
Renfro Tools
 Pool _____
Biddle NW

FIRST REPORT
 OCT 31 56
 0

Date Comm. spd. 10-25-56
8" @ 151 w/130, Stall Li. 1903, Stall Sd
1925, Drlg. 2006

29

Co.
 Lse.
 No.
 Sec.
 T.
 R.

County Cowley Elev. 1236
 Sec. 1 Twp. 32 Rge. 4E
 Company O. A. Sutton & Sunray Mid-Continent
 Name Roberts No. 1

	DEPTH	LOG	DATUM
TP			
H.			
Tr.			
Dg. <u>Stall Li</u>	<u>1903</u>		
Bl. <u>" sd</u>	<u>1925</u>		
L. <u>Lay</u>	<u>2345</u>		
K.C.	<u>2460</u>		
B.K.C. <u>osw</u>	<u>2697</u>		
C. <u>Cattle zn</u>	<u>2910-40</u>		
C. <u>Bt zn</u>	<u>3008-12</u>		
M.			
M.			
K.			
Mz.			
Me.			
V.			
S.			
S.			
A.			
R.			
PE.			
G.			
TD.	<u>3037</u>		

Loc. in Sec. NE SE SW
 Geol. _____
 Contr. Renfro Tools
 Pool Biddle NW

ABANDONED
 NOV 7 '56
 6

Date Comm. spd. 10-25-56
8" @ 151 w/130; Stall Li. 1903, Stall Sd
1925, Drlg. 2006 NOV 7 '56 Lay 2345
Kc 2460 osw 2697 Cattle zn 2910-40
BtV. zn. 3008-12 shly RTD 3037
Lg?

D&A

Co.
 Lse.
 No.
 Sec.
 T.
 R.