


Section 8 Township 32 Range 4-E

Well No. 2 Whitson

Company Earl Wakefield et al

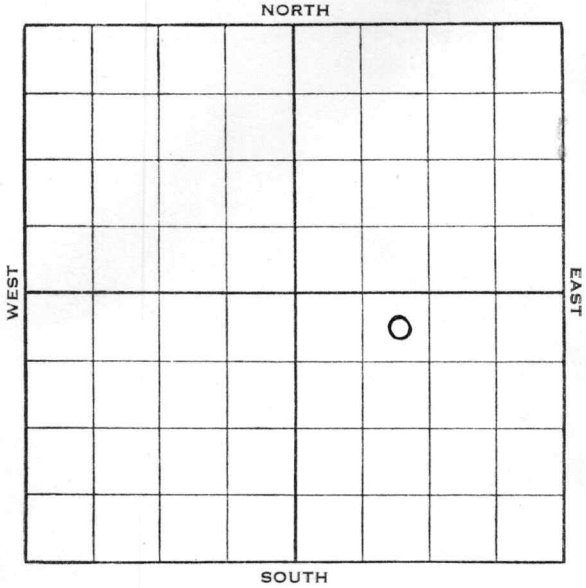

Sec. 8 Twp. 32 R. 4-E

Well No. #2 Whitson Farm

Earl Wakefield et al Company


330 Ft. from N. Line

_____ Ft. from S. Line

_____ Ft. from E. Line

990 Ft. from W. Line

Elev. 1153

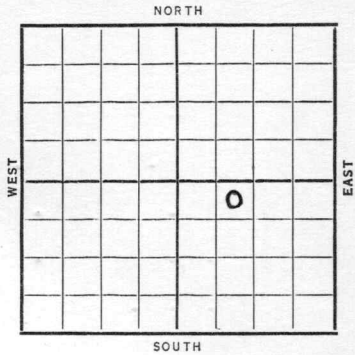

Date	REPORT
1938	
3/9	Cellar.
3/18	Rig.
3/25	R. U.
4/1	"
4/8	"
4/15	"
4/22	Spud.
4/29	Drlg. 600'.
5/6	15" @ 398'. 12" @ 1196'.
	Drlg. 1585'.
5/12	10" @ 1598'. Drlg. 1800'.
5/20	8" @ 2173'. Drlg. 2240'.
5/27	Drlg. 2820'.
6/3	6" @ 2990'. Drlg. 3147'.
6/10	" " " " "

OVER

8

1938

6/15 Stalnaker 1940'.

Miss. 2990'.

Arb. 3355'.

T.D. 3400'.

H.F.W.

ABANDONED

Map No. 2 Sec. 8 Twp. 32 R. 4E

Well No. 2 Whitson

Earl Wakefield etal Company

FIRST REPORT Contractor

SECTION PLAT

NE NW SE

330 Ft. from N. Line

_____ Ft. from S. Line

_____ Ft. from E. Line

990 Ft. from W. Line

		0	

Location _____

RECORD

Cased _____ in., _____ ft.

Sand _____

Gas _____

Oil _____

Total Depth _____

PRODUCTION

1st 24 hrs. Nat. _____

1st 24 hrs. after shot _____

Gas _____ Cu. Ft.

Dry Hole _____

Abandoned _____

Rig up _____

Drilling and Remarks:

Cellar

Date

MAR 9 - 1938

19

H. D. Hatfield

Scout

Cowley KANSAS

Map No. 2 Sec. 8 Twp. 32 R. 4E

Well No. 2 Whitson

Earl Wakefield etal Company

Contractor

ABANDONED

SECTION PLAT

NE NW SE
330 Ft. from N. Line
 _____ Ft. from S. Line
 _____ Ft. from E. Line
990 Ft. from W. Line

		○	

Location _____

Rig up _____

Drilling and Remarks:

Stalner 1940
MISS 2990
Arb 3355
T.D. 3400
HFW
DVA

RECORD

Cased _____ in., _____ ft.
 Sand _____
 Gas _____
 Oil _____
 Total Depth _____

PRODUCTION

1st 24 hrs. Nat. _____
 1st 24 hrs. after shot _____
 Gas _____ Cu. Ft.
 Dry Hole _____
 Abandoned _____

Date

JUN 15 1938

19

H. D. Hatfield Scout