



Cowley

Form 252-A  
5M 4-32 MPC

KANSAS

Map No. \_\_\_\_\_ Sec. 2 Twp. 32 R. 4E

Well No. 1 - Mc Knabb Farm


N.V. Armer + Home Nat Gas Company

990 Ft. from N. Line

\_\_\_\_\_ Ft. from S. Line

330 Ft. from E. Line

\_\_\_\_\_ Ft. from W. Line

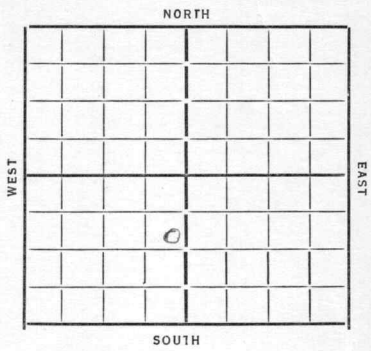

Date  
1933

REPORT

- 7/12 location
- 7/19 Bldg Riser
- 7/26 Rigw up
- 8/2 15" - 364 HOrlg 575'
- 8/9 HOrlg 1456'
- 8/17 10" - 1587 MR - 1766 @.0,
- 8/22 dely 2390'
- 8/30 Chat 2977 - 82 S.D. for 6"
- 9/6 6" at 2983' HOrlg 3301
- 9/13 Siliceous 3393
- T. D. 3405
- D. + a. 3405

ABANDONED

Map No. 2 Sec. 2 Twp. 32 R. 4 E

Well No. 1- McKnabb

N.V. Kriner & Home Nat Gas Company

Contractor

SECTION PLAT


990 Ft. from N. Line

..... Ft. from S. Line

330 Ft. from E. Line

..... Ft. from W. Line

FIRST REPORTS

Location.....

Rig up.....

Drilling and Remarks:

RECORD

Cased..... in., ..... ft.

Sand.....

Gas.....

Oil.....

Total Depth.....

PRODUCTION

1st 24 hrs. Nat.....

1st 24 hrs. after shot.....

Gas..... Cu. Ft.

Dry Hole.....

Abandoned.....

Date

7/17/33 192

Oval Manscheek Scout

Map No. 2 Sec. 2 Twp. 32 R. 4E

Well No. 1-McKnabb

Armed + Home Nat Company

Contractor

SECTION PLAT

990 Ft. from N. Line

..... Ft. from S. Line

330 Ft. from E. Line

..... Ft. from W. Line

		0	

ABANDONED

Location.....

Rig up.....

Drilling and Remarks:

10 + 17

RECORD

Cased..... in., ..... ft.

Sand silicious 3393

Gas.....

Oil.....

Total Depth 3405

PRODUCTION

1st 24 hrs. Nat.....

1st 24 hrs. after shot.....

Gas..... Cu. Ft.

Dry Hole.....

Abandoned.....

Date

9/13/33 192 Orval Mansbach Scout