


Section 7 Township 32 Range 4E

Well No. #1 Ogilbee (Oglesby)

Company Don Cooper et al

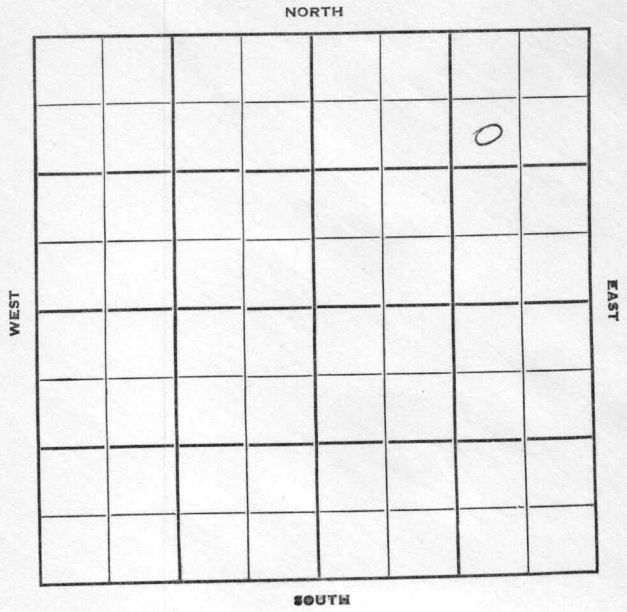

Sec. 7 Twp. 32 R. 4-E

Well No. #1 Ogilbee Farm

Don Cooper etal Company

Contractor


990 Ft. from N. Line

Ft. from S. Line

1140 Ft. from E. Line

Ft. from W. Line

SW NE NE

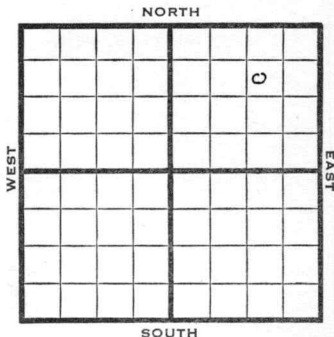

1950

Elev 1143

REPORT

8/30

Drlg

9/6

Spud 8-28-50

8" @ 74

Stal 1960

Shale 2030

TD 2032

D&A

ABANDONED

County Cowley State Kansas

Sec. 7 (Blk. 32) (Sur. 4E) (Rge.) Map No.

Operator Don Cooper etal.

Well No. 1 Farm Ogilbee

Elev. 1143 Location SW NE NE

990 Ft. From N Line NE

1140 Ft. From E Line Quarter

1st. Report

Completion SEP 6 1950

Remarks twin well

Spudding Date 8-28-50

Drlg. Data D & A TD 2032

8" @ 74 Stal. 1960 Shale 2030 TD 2032

D & A

J. E. TYRA