

14

WEST

EAST

SOUTH

Location.....

Drilling Remarks

Rig Up.....

Drilling Remarks

RECORD

Cased.....in.....ft.

Sand.....

Gas.....

Oil _____

Total Depth.....

PRODUCTION

1st 24 hrs. Nat.....

1st 24 hrs. after shot.....


Gas. cu. ft.

Dry Hole

Abandoned.....

Map No. **KANSAS** Sec. 11 Twp. 27 R. 3
Well No. 2- Marshall Farm
W. H. Patton Company

_____ Ft. from W. Line

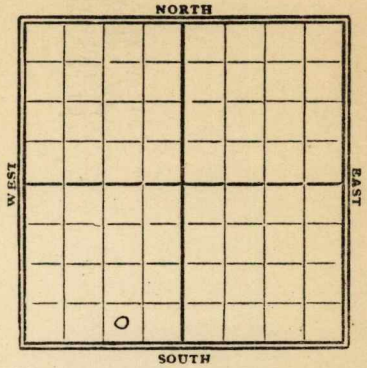

1929

REPORT

REPORT

Location

5/8

$$\frac{5}{15}$$
$$\frac{57}{22}$$

5/29

$$\begin{array}{r} 615 \\ 16.7 \end{array}$$

112
149

6136

Abandon location

Butler

KANSAS

Map No. _____ Sec. *11* Twp. *27* R. *5*

Well No. *2* *Marshall*

H. H. Patton _____ Company

_____ Contractor

FIRST REPORTS**SECTION PLAT**

_____ Ft. from N. Line

330 _____ Ft. from S. Line*990* _____ Ft. from E. Line

_____ Ft. from W. Line

Location *✓* _____

Rig up _____

Drilling and Remarks:

RECORD

Cased _____ in., _____ ft.

Sand _____

Gas _____

Oil _____

Total Depth _____

PRODUCTION

1st 24 hrs. Nat. _____

1st 24 hrs. after shot _____

Gas _____ Cu. Ft.

Dry Hole _____

Abandoned _____

Date

MAY 1 1929

192

CHAS. L. SHERWOOD

Scout

11 **KANSAS** Sec. 11 Twp. 27 R. 5

Well No. 2 Marshall

H. H. Patton Company

Contractor

COMPLETE

SECTION PLAT

.....Ft. from N. Line

330 Ft. from S. Line

990 Ft. from E. Line

.....Ft. from W. Line

ABANDONED

Location.....

Rig up.....

Drilling and Remarks:

RECORD

Cased.....in.,ft.

Sand.....

Gas.....

Oil.....

Total Depth.....

PRODUCTION

1st 24 hrs. Nat.....

1st 24 hrs. after shot.....

Gas.....Cu. Ft.

Dry Hole.....

Abandoned location

Date

JUN 26 1929

192

CHAS. L. SHERWOOD Scout