


KANSAS

Cowley county

Section 7 Township 32 Range 4-E

Well No. #1, "C!" Oglebee (Oglesby)

Company E. Wakefield

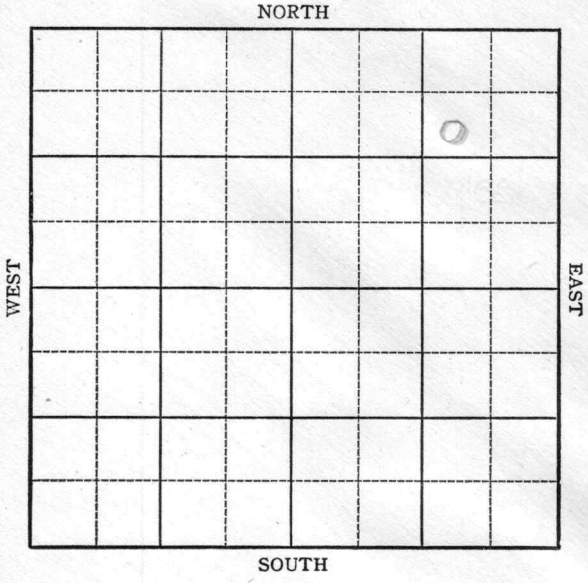

Sec. 7 Twp. 32 R. 4E

Well No. #1 "C" Oglebee (Twin) Farm
E. Wakefield Company


Miscellaneous

1125 Ft. from N. Line

 Ft. from S. Line

990 Ft. from E. Line

 Ft. from W. Line

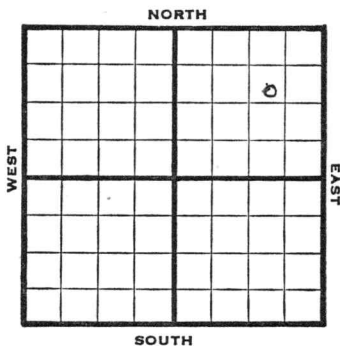

SW NE NE

REPORT

1946

- 10/16 Twin Well
Rig
- 10/22 Drlg 253'
- 10/29 15" @ 28'
12" @ 266'
Drlg 1208'
- 11/6 8" @ 1648'
Drlg 1885'
- 11/13 Stal 1955'
TD 2015'

ABANDONED

Map No. 2 Sec. 7 Twp. 32 R. 4E

Well No. 1 "C" Oglebee

E. Wakefield Company

FIRST REPORT Contractor

SW NE NE

SECTION PLAT

1125 Ft. from N. Line

_____ Ft. from S. Line

990 Ft. from E. Line

_____ Ft. from W. Line

			o

Cowley County

Location _____

Rig up _____

Drilling and Remarks:

twin well
Rig

RECORD

Cased _____ in., _____ ft.

Sand _____

Gas _____

Oil _____

Total Depth _____

PRODUCTION

1st 24 hrs. Nat. _____

1st 24 hrs. after shot _____

Gas _____ Cu. Ft.

Dry Hole _____

Abandoned _____

Date

OCT 16 1946

19

S. J. LEWIS

Scout

Form 26 200 Bks. 10-46 Petrol
Kansas

Map No. 2 Sec. 7 Twp. 32 R. 4E

Well No. 1 "C" Oglebee

E. Wakefield Company

ABANDONED Contractor

SW NE NE

SECTION PLAT

1125 Ft. from N. Line

_____ Ft. from S. Line

990 Ft. from E. Line

_____ Ft. from W. Line

			0

Cowley County

Location _____

Rig up _____

Drilling and Remarks:

Stal 1955

RECORD

Cased _____ in., _____ ft.

Sand _____

Gas _____

Oil _____

Total Depth 2015

PRODUCTION

1st 24 hrs. Nat. _____

1st 24 hrs. after shot _____

Gas _____ Cu. Ft.

Dry Hole _____

Abandoned _____

Date

NOV 13 1946 19 _____

S. J. LEWIS Scout