

KANSAS


Form 51-5M-11-38-Palace

Cowley

Section 9 Township 32 Range 4-E

Well No. #1 Graham

Company Baden et al
~~George Johnston~~

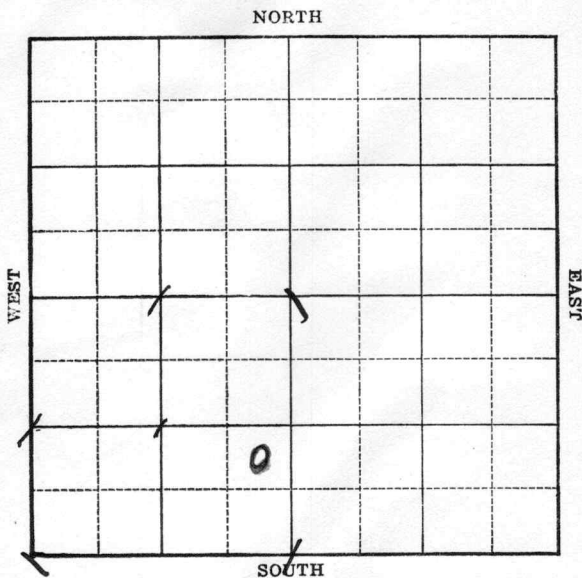

Sec. 9 Twp. 32 R. 4-E

Well No. #1 Graham Farm

~~Geo. Johnston~~ Baden et al Company

(Semi-Wildcat)


_____ Ft. from N. Line

990 Ft. from S. Line

330 Ft. from E. Line

_____ Ft. from W. Line

Elev. 1189

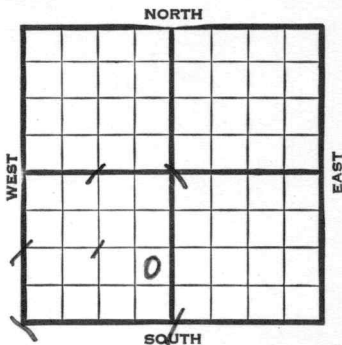

1939	REPORT
7/26	Rotary.
8/3	"
8/10	10" - 101' Drlg. 1440'
8/17	Miss. 2980' Drlg. 3074'
8/23	Arb. 3321'
	5" - 3296'
	T.D. 3326'
	Water.
	ABANDONED

Map No. 2 Sec. 9 Twp. 32 R. 4E

Well No. 1 Graham

Geo. Johnston Company

Contractor

FIRST REPORT

NE SE SW


_____ Ft. from N. Line

990 Ft. from S. Line

330 Ft. from E. Line

_____ Ft. from W. Line

SECTION PLAT

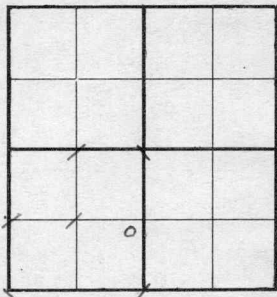

SEMI-WILDCAT

Location _____

Rig up _____

Drilling and Remarks:
Rotary

RECORD

Cased _____ in., _____ ft.

Sand _____

Gas _____

Oil _____

Total Depth _____

PRODUCTION

1st 24 hrs. Nat. _____

1st 24 hrs. after shot _____

Gas _____ Cu. Ft.

Dry Hole _____

Abandoned _____

Date

JUL 26 1939 19

S. J. LEWIS

Scout

Map No. 2 Sec. 9 Twp. 32 R. 4E

Well No. 1 Graham

Baden etal Company

CORRECTION Contractor

NE SE SW


_____ Ft. from N. Line

990 Ft. from S. Line

330 Ft. from E. Line

_____ Ft. from W. Line

SECTION PLAT

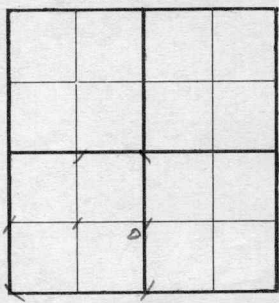

Location _____

Rig-up _____

Drilling and Remarks:

Reported:

Geo. Johnston

RECORD

Cased _____ in., _____ ft.

Sand _____

Gas _____

Oil _____

Total Depth _____

PRODUCTION

1st 24 hrs. Nat. _____

1st 24 hrs. after shot _____

Gas _____ Cu. Ft.

Dry Hole _____

Abandoned _____

Date

AUG 2 1939

19

S. J. LEWIS

Scout

KANSAS Cowley


Map No. 2 Sec. 9 Twp. 33 R. 4E

Well No. 1 Graham

Baclen & Co Company

NE SE 896 Contractor

SECTION PLAT

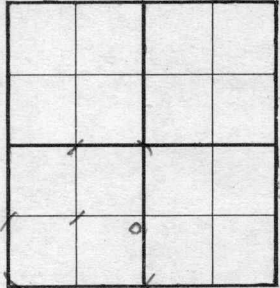

ABANDONED

_____ Ft. from N. Line

990 Ft. from S. Line

330 Ft. from E. Line

_____ Ft. from W. Line

Semi-Abandoned

Location _____

Rig up _____

Drilling and Remarks:

Oil 3321

5" C 3296

Water

RECORD

Cased in., ft.

Sand

Gas

Oil

Total Depth 3326

PRODUCTION

1st 24 hrs. Nat.

1st 24 hrs. after shot

Gas Cu. Ft.

Dry Hole

Abandoned

Date

AUG 23 1939 19

S. J. LEWIS Scout