

Sawley

FORM 252A-5M-12-28-PETROL

Map No. KANSAS Sec. 9 Twp. 32 R. 4


Well No. 1-Mitchell Farm
Prairie & Mc Nabbs Company

_____ Ft. from N. Line

330 Ft. from S. Line

990 Ft. from E. Line

_____ Ft. from W. Line

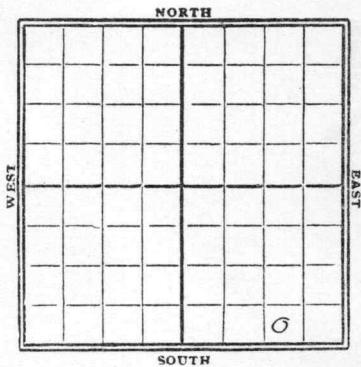

1929

Date

REPORT

Date	REPORT
3/13	Prod.
3/20	Spdy.
3/27	Drly 675'
4/3	" 1565'
4/10	" 1800'
4/17	stg 8"-2120'
4/24	Drly 2460'
5/11	" 3050'
5/18	Oil line 3291-93' 800 bbls oil
5/15	sand 3291-95 T.D. 3295 1055 bbls oil Comp.

Cowley

Map No. 2 KANSAS Sec. 9 Twp. 32 R. 14

Well No. 1 Mitchelen

Prairie & Mc Nab Company

Contractor

FIRST REPORTS

SECTION PLAT

Ft. from N. Line

330 Ft. from S. Line

990 Ft. from E. Line

Ft. from W. Line

Location ROS

Rig up

Drilling and Remarks:

RECORD

Cased.....in.,ft.

Sand.....

Gas.....

Oil.....

Total Depth.....

PRODUCTION

1st 24 hrs. Nat.....

1st 24 hrs. after shot.....

Gas.....Cu. Ft.

Dry Hole.....

Abandoned.....

Date
MAR 13 1929

CHAS. L. SHERWOOD

192..... Scout

Cowley

Map No. ² KANSAS Sec. 9 Twp. 32 R. 4

Well No. 1 Mitcheler

Prairie & McHabb Company

Contractor

COMPLETE

SECTION PLAT

Ft. from N. Line

330 Ft. from S. Line

990 Ft. from E. Line

Ft. from W. Line

			0

Location

Rig up

Drilling and Remarks:

1055 Bls.

RECORD

Cased in., ft.

Sand 3291-3295

Gas

Oil

Total Depth 3295

PRODUCTION

1st 24 hrs. Nat.

1st 24 hrs. after shot

Gas Cu. Ft.

Dry Hole

Abandoned

Date

MAY 15 1929

192

CHAS. L. SHERWOOD

Scout