



Map No. KANSAS Sec. 10 Twp. 32 R. 4


Well No. 1-Graham Farm  
Prairie Oil Co. Company

\_\_\_\_\_ Ft. from N. Line

330 Ft. from S. Line

330 Ft. from E. Line

\_\_\_\_\_ Ft. from W. Line

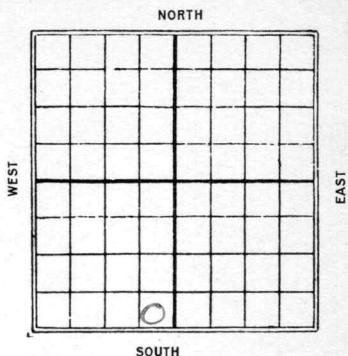

1927

Date	REPORT
<u>11/23</u>	<u>Rig up</u>
<u>11/30</u>	<u>Rigging up</u>
<u>12/7</u>	<u>Spudding</u>
<u>12/14</u>	<u>Drlg 450'</u>
<u>12/21</u>	<u>" 1220</u>
<u>12/29</u>	<u>" 1630</u>
<u>1928</u>	
<u>1/5</u>	<u>u.R. 10"-1720</u>
<u>1/11</u>	<u>—</u>
<u>1/18</u>	<u>fishing 1730</u>
<u>1/26</u>	<u>—</u>
<u>2/2</u>	<u>—</u>
<u>2/9</u>	<u>Skidding rig - T.D. 1730.</u>
<u>2/16</u>	<u>Drlg 450 - new hole -</u>
<u>2/23</u>	<u>" 1080</u>
<u>3/1</u>	<u>" 1775</u>
<u>3/8</u>	<u>" 2100</u>
<u>3/16</u>	<u>" 2500</u>
<u>3/22</u>	<u>Setting 8" - 2500</u>
<u>3/29</u>	<u>Drilling 2535</u>
<u>4/5</u>	<u>Top line 2960 - drlg 2980.</u>
<u>4/12</u>	<u>Base line 3240 - sand 3315 - 24 in sand - shut down</u>

4/19-3315-3322-H.F.W.

T.D. 3322 T.L. 2960-3240

N.T.A. 3322'

Cowley

2 KANSAS Map No. Sec. 10 Twp. 32 R. 4

Well No. 1 Graham

Pratt Oil & Gas Co Company

Contractor

FIRST REPORTS

SECTION PLAT

----- Ft. from N. Line

330 Ft. from S. Line

330 Ft. from E. Line

----- Ft. from W. Line

	X	X	
		o	

Location -----

Rig up -----

Drilling and Remarks:

RECORD

Cased ----- in., ----- ft.

Sand -----

Gas -----

Oil -----

Total Depth -----

PRODUCTION

1st 24 hrs. Nat. -----

1st 24 hrs. after shot -----

Gas ----- Cu. Ft.

Dry Hole -----

Abandoned -----

Date

NOV 23 1927

CHAS. L. SHERWOOD

*Lowley*

Map No. 2 KANSAS Sec. 10 Twp. 32 R. 4

Well No. 1 *Shakam*

*Prairie Oil & Gas Co* Company

Contractor

COMPLETED

SECTION PLAT

----- Ft. from N. Line

330 Ft. from S. Line

330 Ft. from E. Line

----- Ft. from W. Line

ABANDONED


Location -----

Rig up -----

Drilling and Remarks:

*Th 2960 - 3240'*

*DDA*

RECORD

Cased \_\_\_\_\_ in. \_\_\_\_\_ ft.

Sand 3315 - 3322 *NEW*

Gas -----

Oil -----

Total Depth 3322

PRODUCTION

1st 24 hrs. Nat. -----

1st 24 hrs. after shot -----

Gas ----- Cu. Ft.

Dry Hole  -----

Abandoned  -----

Date

APR 19 1928

192

CHAS. L. SHERWOOD

Scout

*Cowley*

MAP NO. K2 KANSAS SEC. 10 TWP. 32S R. 4E

WELL NO. 1 A. Graham

Prarie COMPANY

CONTRACTOR

ABANDONED

SECTION PLAT


\_\_\_\_\_ FT. FROM N. LINE

\_\_\_\_\_ FT. FROM S. LINE

\_\_\_\_\_ FT. FROM E. LINE

\_\_\_\_\_ FT. FROM W. LINE

RECORD

LOCATION \_\_\_\_\_

RIG UP \_\_\_\_\_

DRILLING AND REMARKS:



CASED \_\_\_\_\_ IN. \_\_\_\_\_ FT.

SAND \_\_\_\_\_

GAS \_\_\_\_\_

OIL \_\_\_\_\_

TOTAL DEPTH 3322

PRODUCTION

1ST 24 HRS. NAT. \_\_\_\_\_

1ST 24 HRS. AFTER SHOT \_\_\_\_\_

GAS \_\_\_\_\_ CU. FT.

DRY HOLE \_\_\_\_\_

ABANDONED \_\_\_\_\_

DATE

4/14 1928

SCOUT