

Butler

Map No. Kansas Sec. 14 Twp. 27 R. 5


Well No. 1 Gensch Farm

H. H. Patton et al Company

NORTH

(Zeiset)

5

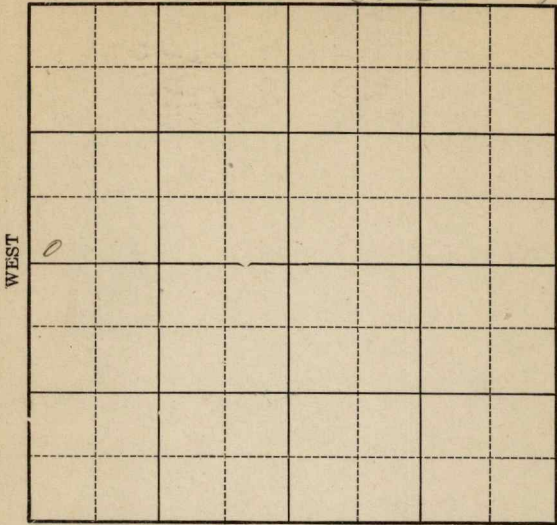

SOUTH

Location _____

Rig Up _____

Drilling Remarks _____

Drilling Remarks _____

RECORD

PRODUCTION

Cased _____ in. _____ ft.

1st 24 hrs. Nat. _____

Sand _____

1st 24 hrs. after shot _____

Gas _____

Gas _____ cu. ft.

Oil _____

Dry Hole _____

Total Depth _____


Abandoned _____

Butler

Map No. Kansas Sec. 14 Twp. 27 R. 5

Well No. 1 Bessie Farm
H. H. Patton et al Company

..... Ft. from N. Line
330 Ft. from S. Line
 Ft. from E. Line
330 Ft. from W. Line

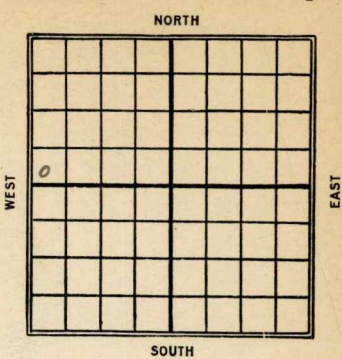

Date	REPORT
1921	
5/19	R.O.G.
6/2	Rig.
6/10	rigging up
6/18	Dlg 500
6-25	" 925
6-30	8/0 qrs
7/8	D lg 1630
7/15	" 2135
7/22	" 2475
7-28	sand 2745-58'
	D lg 2770
8/4	s.d 2835 Ref rig.
8/11	U.P. 2880
8/18	D lg 3020
8-25	sand 2745-58'
	top line 2758 - Wil. 3165
	to 88', D. & A. 3190 H.F.W.
	J.D. 3190

Button

Map No. K11 KANSAS Sec. 14 Twp. 27 R. 5

Well No. 1 Zeiset

H. H. Patton et al Company

Contractor

FIRST REPORTS

SECTION PLAT

_____ Ft. from N. Line

330

_____ Ft. from S. Line

_____ Ft. from E. Line

330

_____ Ft. from W. Line

o			

Location _____

Rig up _____

Drilling and Remarks:

Ro 8

RECORD

Cased _____ in., _____ ft.

Sand _____

Gas _____

Oil _____

Total Depth _____

PRODUCTION

1st 24 hrs. Nat. _____

1st 24 hrs. after shot _____

Gas _____ Cu. Ft.

Dry Hole _____

Abandoned _____

Date

MAY 19 1926

CHAS. L. SHERWOOD

192

Scout

Button

11 **KANSAS** Map No. _____ Sec. *14* Twp. *27* R. *5*

Well No. *1* *Zeisoff*
H. H. Button et al Company _____ Contractor _____

COMPLETED

SECTION PLAT

_____ Ft. from N. Line

330

_____ Ft. from S. Line

_____ Ft. from E. Line

330

_____ Ft. from W. Line

<i>6</i>			

ABANDONED

Location _____

Rig up _____

Drilling and Remarks:

Sand 2745-58

Top lens 2758'

Nileox 3165-88

DOG 3190

HFW

RECORD

Cased _____ in., _____ ft.

Sand _____

Gas _____

Oil _____

Total Depth *2190*

PRODUCTION

1st 24 hrs. Nat. _____

1st 24 hrs. after shot _____

Gas _____ Cu. Ft.

Dry Hole

Abandoned

Date

AUG 25 1926

CHAS. L. SHERWOOD

192

Scout