



Cowling

Map No. KANSAS Sec. 12 Twp. 32 R. 4E


Well No. 6 Holt Farm  
Roth & Faust Company

990 Ft. from N. Line

\_\_\_\_\_ Ft. from S. Line

\_\_\_\_\_ Ft. from E. Line

330 Ft. from W. Line

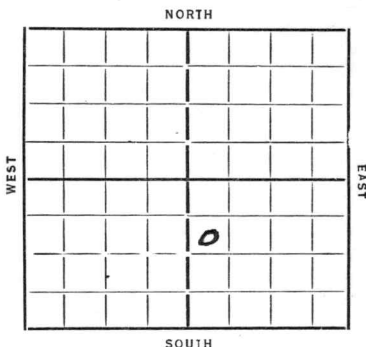

Date	REPORT
1934	
10/31	Location
11/8	Log
11/15	Rib
11/22	Dlg 340
11/28	" 560 15" 400
12/6	" 1135
12/13	" 1405
12/21	" 1515
12/27	" 1655
1/3/35	Steluser 1950 Dlg 2060
1/10	Dlg 2400
1/17	Ren 5" 2578
1/24	_____
1/31	6" 2245 5" 2578
2/7	KC 2578 TD 2644 PB 2633 1000 acid
2/14	_____ 2/21 _____
2/27	KC 2578 TD 2644 1000 acid 10 FT.

ABANDONED

Map No. 2 Sec. 12 Twp. 32 R. 4E

Well No. 6-Holt.

Roth + Franrot Company

Contractor

FIRST REPORTS

SECTION PLAT

990 Ft. from N. Line

\_\_\_\_\_ Ft. from S. Line

\_\_\_\_\_ Ft. from E. Line

330 Ft. from W. Line

		0	

Location

Rig up \_\_\_\_\_

Drilling and Remarks:

RECORD

Cased \_\_\_\_\_ in., \_\_\_\_\_ ft.

Sand \_\_\_\_\_

Gas \_\_\_\_\_

Oil \_\_\_\_\_

Total Depth \_\_\_\_\_

PRODUCTION

1st 24 hrs. Nat. \_\_\_\_\_

1st 24 hrs. after shot \_\_\_\_\_

Gas \_\_\_\_\_ Cu. Ft.

Dry Hole \_\_\_\_\_

Abandoned \_\_\_\_\_

Date

ORVAL MANNSCHRECK

10-31-34 19

Scout

Map No. 2 Sec. 12 Twp. 32 R. 4 E

Well No. 6-Holt

Roth + Gaurat Company

Contractor

ABANDONED

990 Ft. from N. Line

..... Ft. from S. Line

..... Ft. from E. Line

330 Ft. from W. Line

SECTION PLAT

		0	

Location.....

Rig up.....

Drilling and Remarks:

1000 and

10 + A

RECORD

Cased        in.,        ft.

Sand K.C. 2578

Gas.....

Oil.....

Total Depth 2644

PRODUCTION

1st 24 hrs. Nat.....

1st 24 hrs. after shot.....

Gas..... Cu. Ft.

Dry Hole.....

Abandoned.....

Date

2-27-35 192

ORVAL MANNSCHECK  
Scout