


Butler

Section 17 Township 27 Range 5-E

Well No. 1 J. C. Miley

Company T. S. Dustin

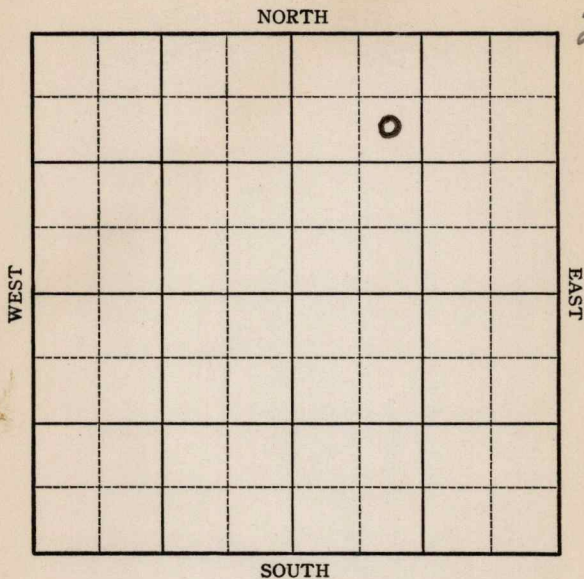

O. W. D. D

Sec. 17 Twp. 27 R. 5-E

Well No. #1 J. C. Miley Farm


T. S. Dustin Company

990 Ft. from N. Line

_____ Ft. from S. Line

_____ Ft. from E. Line

990 Ft. from W. Line

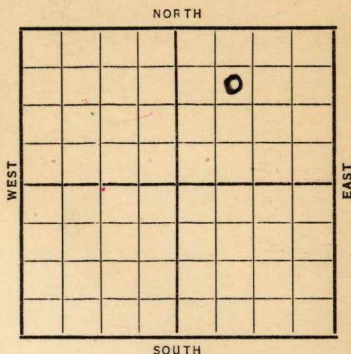

Date	REPORT O. W. D. D
1937	
12/8	Drlg. 395'.
12/17	T.D. 395' SD.
12/24	" " "
12/31	" " "
1938	
1/7	" " "
1/14	" " "
1/20	" " "
1/28	" " "
2/4	" " "
2/11	Drlg. 810'.
2/18	Shut down.
2/26	" "
3/4	" "
3/11-	" "
3/18	" "
3/25	" "
4/1	" "
4/8	10" @ 865'.
	Drlg. 965'.

OVER

1938

4/15

TD 990'.

U. R. 10".

4/22

10" @ 990'. Drlg. 1050'.

4/29

" " " "

5/6

" " " "

5/12

" " " "

5/20

" " " "

5/27

8" @ 1512'. S.G. 1955-65'.

Cleaning out.

6/3

SD 2008' S. W.

6/10

" " "

6/17

" " "

6/24

" " "

7/1

" " "

7/8

" " "

7/15

" " "

7/22

" " "

7/27

8" - 1512'.

Lans. 1837'.

T. D. 2008'.

ABANDONED

ABANDONED

ABANDONED

OVER

1938

O. W. D. D

8/31

Old T. D. 2008'.

Drlg. 2070'.

K. C. 2160'.

T. D. 2178' no shows.

FIRST REPORT

and

ABANDONED

Butler

KANSAS.

Map No. 11 Sec. 17 Twp. 27 R. 5E

Well No. 1 J. C. Miley

T. S. Dustin Company

Contractor

FIRST REPORT

SECTION PLAT

SE NW NE

990 Ft. from N. Line

_____ Ft. from S. Line

_____ Ft. from E. Line

990 Ft. from W. Line

		o	

Location _____

Rig up _____

Drilling and Remarks:

Drlg. 395

RECORD

Cased _____ in., _____ ft.

Sand _____

Gas _____

Oil _____

Total Depth _____

PRODUCTION

1st 24 hrs. Nat. _____

1st 24 hrs. after shot _____

Gas _____ Cu. Ft.

Dry Hole _____

Abandoned _____

Date

DEC 8 - 1937 19

H. D. Hatfield Scout

Butler

KANSAS

Map No. 11 Sec. 17 Twp. 27 R. 5E

Well No. 1 J. C. Miley

T. S. Dustin

Company

Contractor

ABANDONED

SE NW NE

990 Ft. from N. Line

_____ Ft. from S. Line

_____ Ft. from E. Line

990 Ft. from W. Line

SECTION PLAT

		0	

Location _____

Rig up _____

Drilling and Remarks:

DVA

RECORD

Cased 8 in., 15 1/2 ft.

Sand LENS 1837

Gas _____

Oil _____

Total Depth 2008

PRODUCTION

1st 24 hrs. Nat. _____

1st 24 hrs. after shot _____

Gas _____ Cu. Ft.

Dry Hole _____

Abandoned _____

Date

JUL 27 1938

19

H. D. Hatfield

Scout

Butler **KANSAS**

Map No. // Sec. **17** Twp. **27** R. **5E**

Well No. **1 Miley**

Dustin etal

Company

FIRST REPORT

Contractor

COMPLETED

SE NW NE

990 Ft. from N. Line

Ft. from S. Line

Ft. from E. Line

990 Ft. from W. Line

SECTION PLAT

		0	

OWDD

Location _____

RECORD

Cased _____ in., _____ ft.

Rig up _____

Sand _____

Drilling and Remarks:

Gas _____

OTD 2008

Oil _____

Drlg. 2070

Total Depth _____

K.C. 2160

PRODUCTION

T.D. 2178 no shows

1st 24 hrs. Nat. _____

1st 24 hrs. after shot _____

D & A

Gas _____ Cu. Ft.

Dry Hole _____

Abandoned _____

Date

AUG 31 1938

H. D. Hatfield

Scout