

Cowley

KANSAS

SECTION 12 TOWNSHIP 32 RANGE 4E


WELL NO. #1 Miller

COMPANY O.H. Parker

NORTH

WEST

EAST

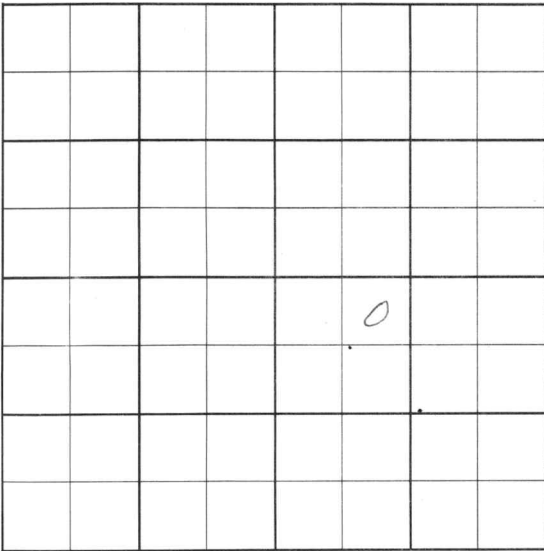

SOUTH

Cowley

KANSAS

SEC.	12	TWP.	32	R.	4E
------	----	------	----	----	----

WELL NO. #1 Miller FARM

COMPANY O. H. Parker

CONTRACTOR Kriswell


WILDCAT

_____ Ft. from N. Line

_____ Ft. from S. Line

_____ Ft. from E. Line

_____ Ft. from W. Line

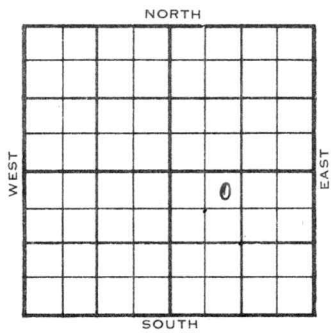

NE NW SE

	ELEVATION	REPORT
1956	1277	

4-4 Comm. 3-29-56
8" @ 122
Drlg. 2370

5-9 DST 2355-70 op 1 hr. rec. 5' drlg. mud,
0/20".
DST 2360-77 op 1 hr. rec. 8' mud,
35/20"
DST 2380-92 op 1 hr. rec. 10' drlg. mud,
500/20#
4 1/2" @ 2600 w/125
CO 24/ 2360-66, 72/ 2370-86, 2388-92
2394-98, frac
S/ 1/4 bo, 3/4 bw,
S/ 6 bo, 35 BW, 8 hrs.
D & A
Hoover 1788', Layton 2354',
Layton sd. 2361', KC 2560'
TD 2600'

ABANDONED

County Cowley Elev. 1277
 Sec. 12 Twp. 32 Rge. 4E
 Company O. H. Parker
 Farm Name Miller No. 1

Co.

TOPS	DEPTH	LOG	DATUM
Anh.			
Tp.			
H.			
Tr.			
Dg.			
Bl.			
L.			
K.C.			
B.K.C.			
Ce.			
C.			
M.			
M.			
K.			
Mz.			
Mq.			
V.			
S.			
S.			
A.			
R.			
PE.			
G.			
T.D.			

Loc. in Sec. NE NW SE

Geol. _____

Contr. Kriswell

Pool Wildcat

FIRST REPORT		0
		APR 4 '56

Lse.

No.

Sec.

T.

R.

Date Comm. 3-29-56
8" @ 122 drlg. 2370

County Cowley Elev. 1277
 Sec. 12 Twp. 32 Rge. 4E
 Company O. H. Parker
 Farm Name Miller No. 1

TOPS	DEPTH	LOG	DATUM
Anh.			
TP.			
H. <u>Hoover</u>	<u>1788</u>		<u>511</u>
T. <u>Dayton</u>	<u>2354</u>		<u>1077</u>
Dg. <u>10 ad</u>	<u>2361</u>		<u>1084</u>
Bl.			
L.			
K.C.	<u>2500</u>		<u>1223</u>
B.K.C.			
Ce.			
C.			
M.			
M.			
K.			
Mz.			
Ma.			
V.			
S.			
S.			
A.			
R.			
PE.			
G.			
T.D.	<u>2600</u>		

Loc. in Sec. NE NW SE

Geol. _____

Contr. _____

Krisswell

Pool

Wildcat



Date Comm. 3-29-56 MAY 9 1956
8" @ 122 DST 2355-70 open 1 hr.

rec. 5' drlg. mud 0/20" DST 2360-77
open 1 hr. rec. 8' mud 35/20"
DST 2380-92 open 1 hr. rec. 10'
drlg. mud 500/20" 4 1/2" @ 200/125
CO 24/ 2360-66 72/ 2370-86
2388-92 2394-98 frac
S/ 1/4 bo 3/4 bw S/ 6 bo 3 bw 8 hr.
D & A

Co.
Lse.
No.
Sec.
T.
R.