

Sowley

Form 51-5M-2-29-34703

Map No. **KANSAS** Sec. 9 Twp. 32 R. 4^E

Well No. 2-Mitchell Farm


Prairie & M^c Kabb Company

NORTH

(Mitschler)

WEST

EAST

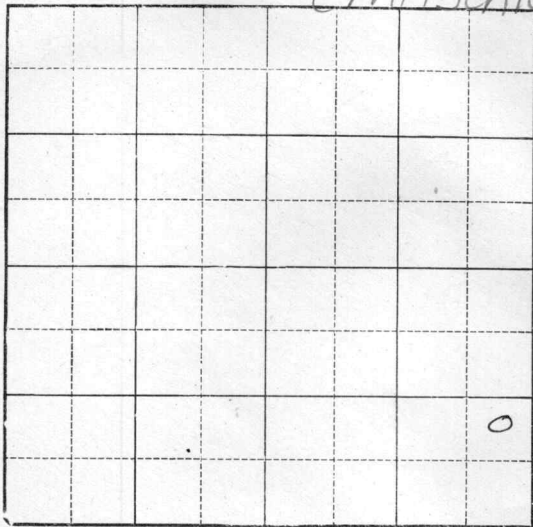

SOUTH

Location _____

Drilling Remarks _____

Rig Up _____

Drilling Remarks _____

RECORD

Cased _____ in. _____ ft.

Sand _____

Gas _____

Oil _____

Total Depth _____

PRODUCTION

1st 24 hrs. Nat. _____

1st 24 hrs. after shot _____

Gas _____ cu. ft.

Dry Hole _____

Abandoned _____

Map No. KANSAS Sec. 9 Twp. 32 R. 4^E


Well No. 2 - Mitchell Farm
Prairie & M^c Nabbe Company

_____ Ft. from N. Line

990 Ft. from S. Line

330 Ft. from E. Line

_____ Ft. from W. Line

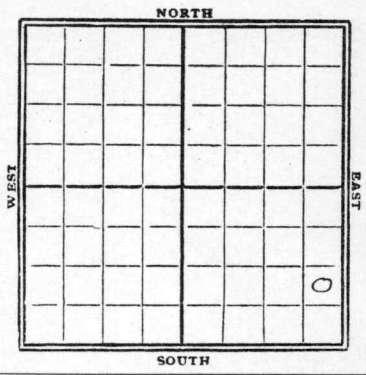

1929

Date

REPORT

Date	REPORT
4/10	RDY
4/17	Bldg Rdy
4/24	2 bldg at 200'
5/1	RDY 1082'
5/8	" 1600'
5/15	" 1905'
5/22	" 2450'
5/29	" 2839'
6/5	" 2839'
6/12	SD 2839'
6/19	rdy 2785' ??
6/26	" 2882'
7/2	chat 2967-80'
	RDY 3160'
7/10	sand 3297-3306'
	T.D. 3306'
	100 bbls oil
	Comp.

2 **KANSAS** *Cowley* *32* *4^E*
Map No. Sec. *9* Twp. R.

Well No. *2* *Mitchler*
Prairie & McHabb Company

..... Contractor

FIRST REPORTS

..... Ft. from N. Line
990 Ft. from S. Line
330 Ft. from E. Line
..... Ft. from W. Line

SECTION PLAT

			o

Location *R.O.S.*
Rig up
Drilling and Remarks:

RECORD

Cased in., ft.
Sand
Gas
Oil
Total Depth

PRODUCTION

1st 24 hrs. Nat.
1st 24 hrs. after shot
Gas Cu. Ft.
Dry Hole
Abandoned

Date

APR 10 1929

192.....

CHAS. L. SHERWOOD

..... Scout

Cowley

Map No. **KANSAS** Sec. *9* Twp. *32* R. *4*

Well No. *2 Mitchler*

Prairie & McNabb Company

Contractor

COMPLETE

SECTION PLAT

..... Ft. from N. Line

990 Ft. from S. Line

330 Ft. from E. Line

..... Ft. from W. Line

Location.....

Rig up.....

Drilling and Remarks:

100 Bb.

RECORD

Cased *32* in., *330* ft.

Sand *2897-2206*

Gas.....

Oil.....

Total Depth *2206*

PRODUCTION

1st 24 hrs. Nat.....

1st 24 hrs. after shot.....

Gas..... Cu. Ft.

Dry Hole.....

Abandoned.....

Date

7/10/29

CHAS. L. SHERWOOD

192.....

Scout